

This map is reproduced from Ordnance Survey material with the permission of Ordnance Survey on behalf of the Controller of Her Majesty's Stationery Office © Crown copyright. Unauthorised reproduction infringes Crown copyright and may lead to prosecution or civil proceedings.

100023420 (2015)

A	CHANGES FOLLOWING T.O. TEAM COMMENTS	MP	27/08/24	JT
REVISION	DETAILS	BY	DATE	CHECKED

EDINBURGH
THE CITY OF EDINBURGH COUNCIL


The City of Edinburgh Council
Waverley Court, 4 East Market Street
Edinburgh, EH8 8BG
Telephone: 0131 200 2000

WASTE

COMMUNAL BIN REVIEW
AMENDMENTS TO TEXT-BASED ORDERS
AREA-PAGE INDEX

Date: 30/05/2024 Job No. Drawn by: MP
Scale: 1:4000 @A0 Checked by: JT



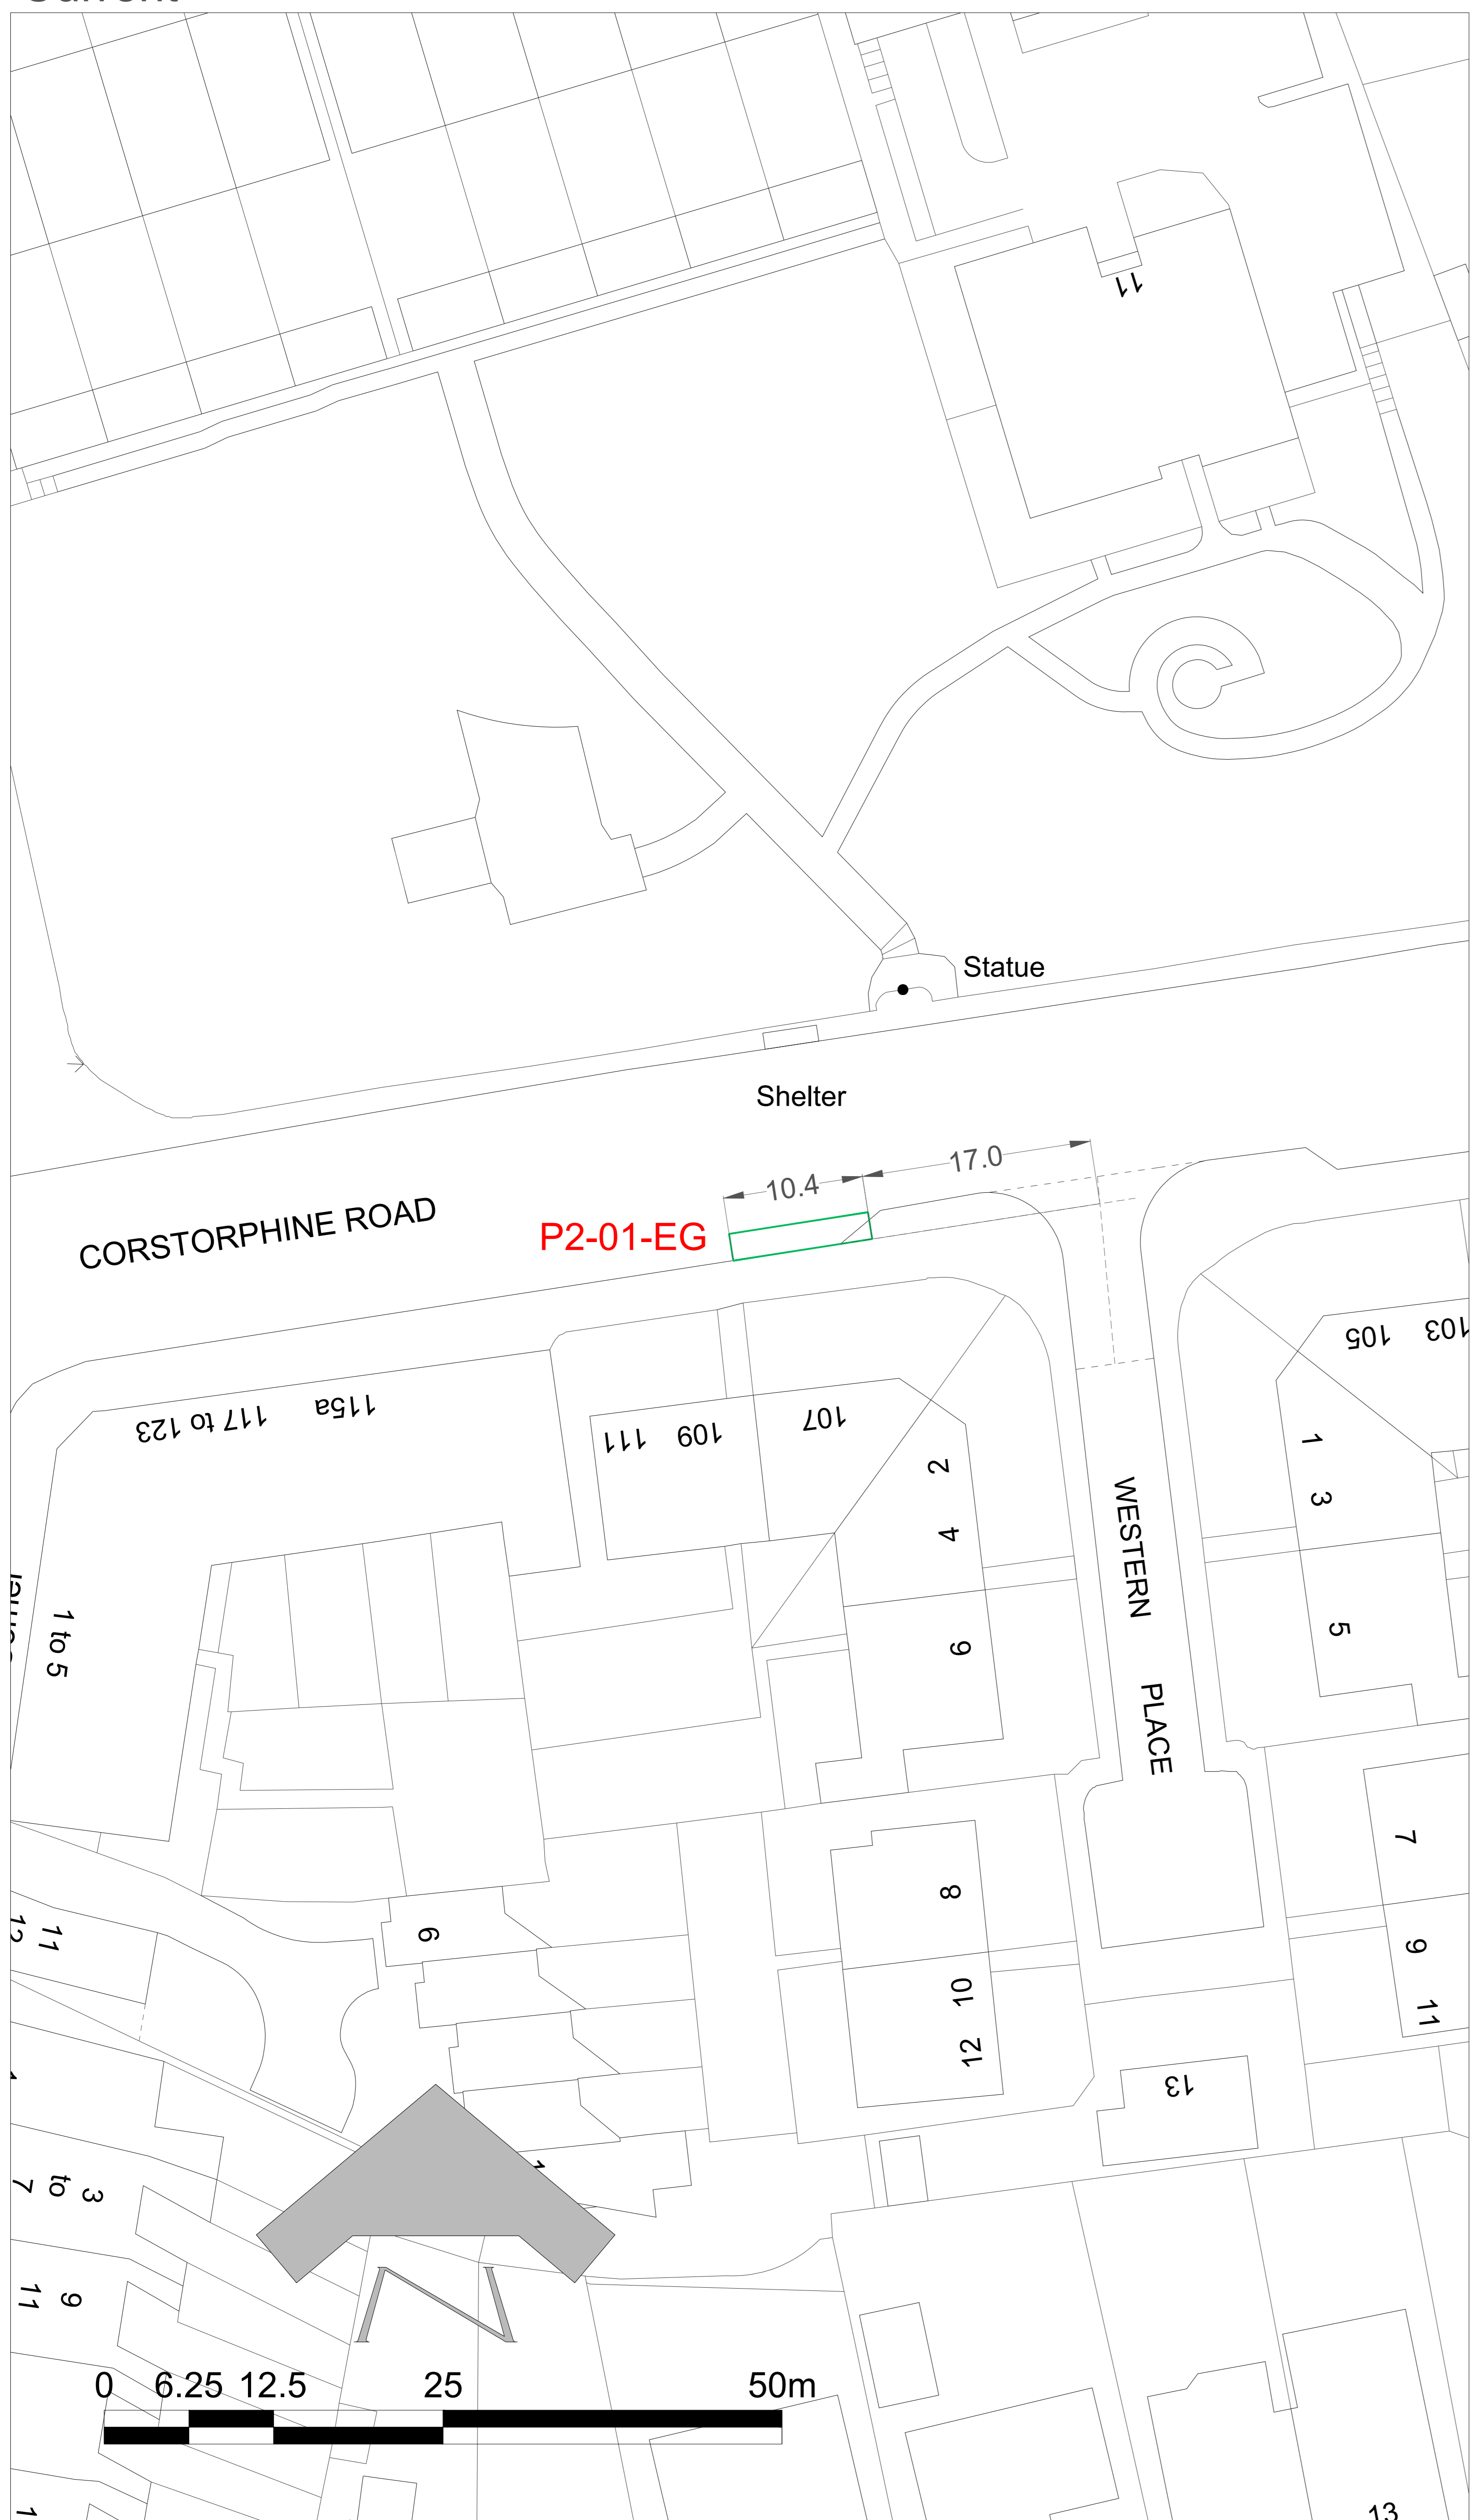



Current



Proposed



KEY

-  DOUBLE YELLOW LINE (DYL)
-  SINGLE RED LINE (SRL)
-  DOUBLE RED LINE (DRL)
-  LOADING BAY
-  GREENWAY LOADING BAY
-  GREENWAY PARKING BAY

This map is reproduced from Ordnance Survey material with the permission of Ordnance Survey on behalf of the Controller of Her Majesty's Stationery Office © Crown copyright. Unauthorised reproduction infringes Crown copyright and may lead to prosecution or civil proceedings.

100023420 (2015)

A	CHANGES FOLLOWING T.O. TEAM COMMENTS	MP	27/08/24	JT
REVISION	DETAILS	BY	DATE	CHECKED

EDINBURGH
THE CITY OF EDINBURGH COUNCIL

The City of Edinburgh Council
Waverley Court, 4 East Market Street
Edinburgh, EH8 8BG
Telephone: 0131 200 2000


WASTE

COMMUNAL BIN REVIEW
AMENDMENTS TO TEXT-BASED ORDERS


PAGE 1

Date: 30/05/2024 Job No. Drawn by: MP
Scale: 1:250 @A0 Checked by: JT

Current

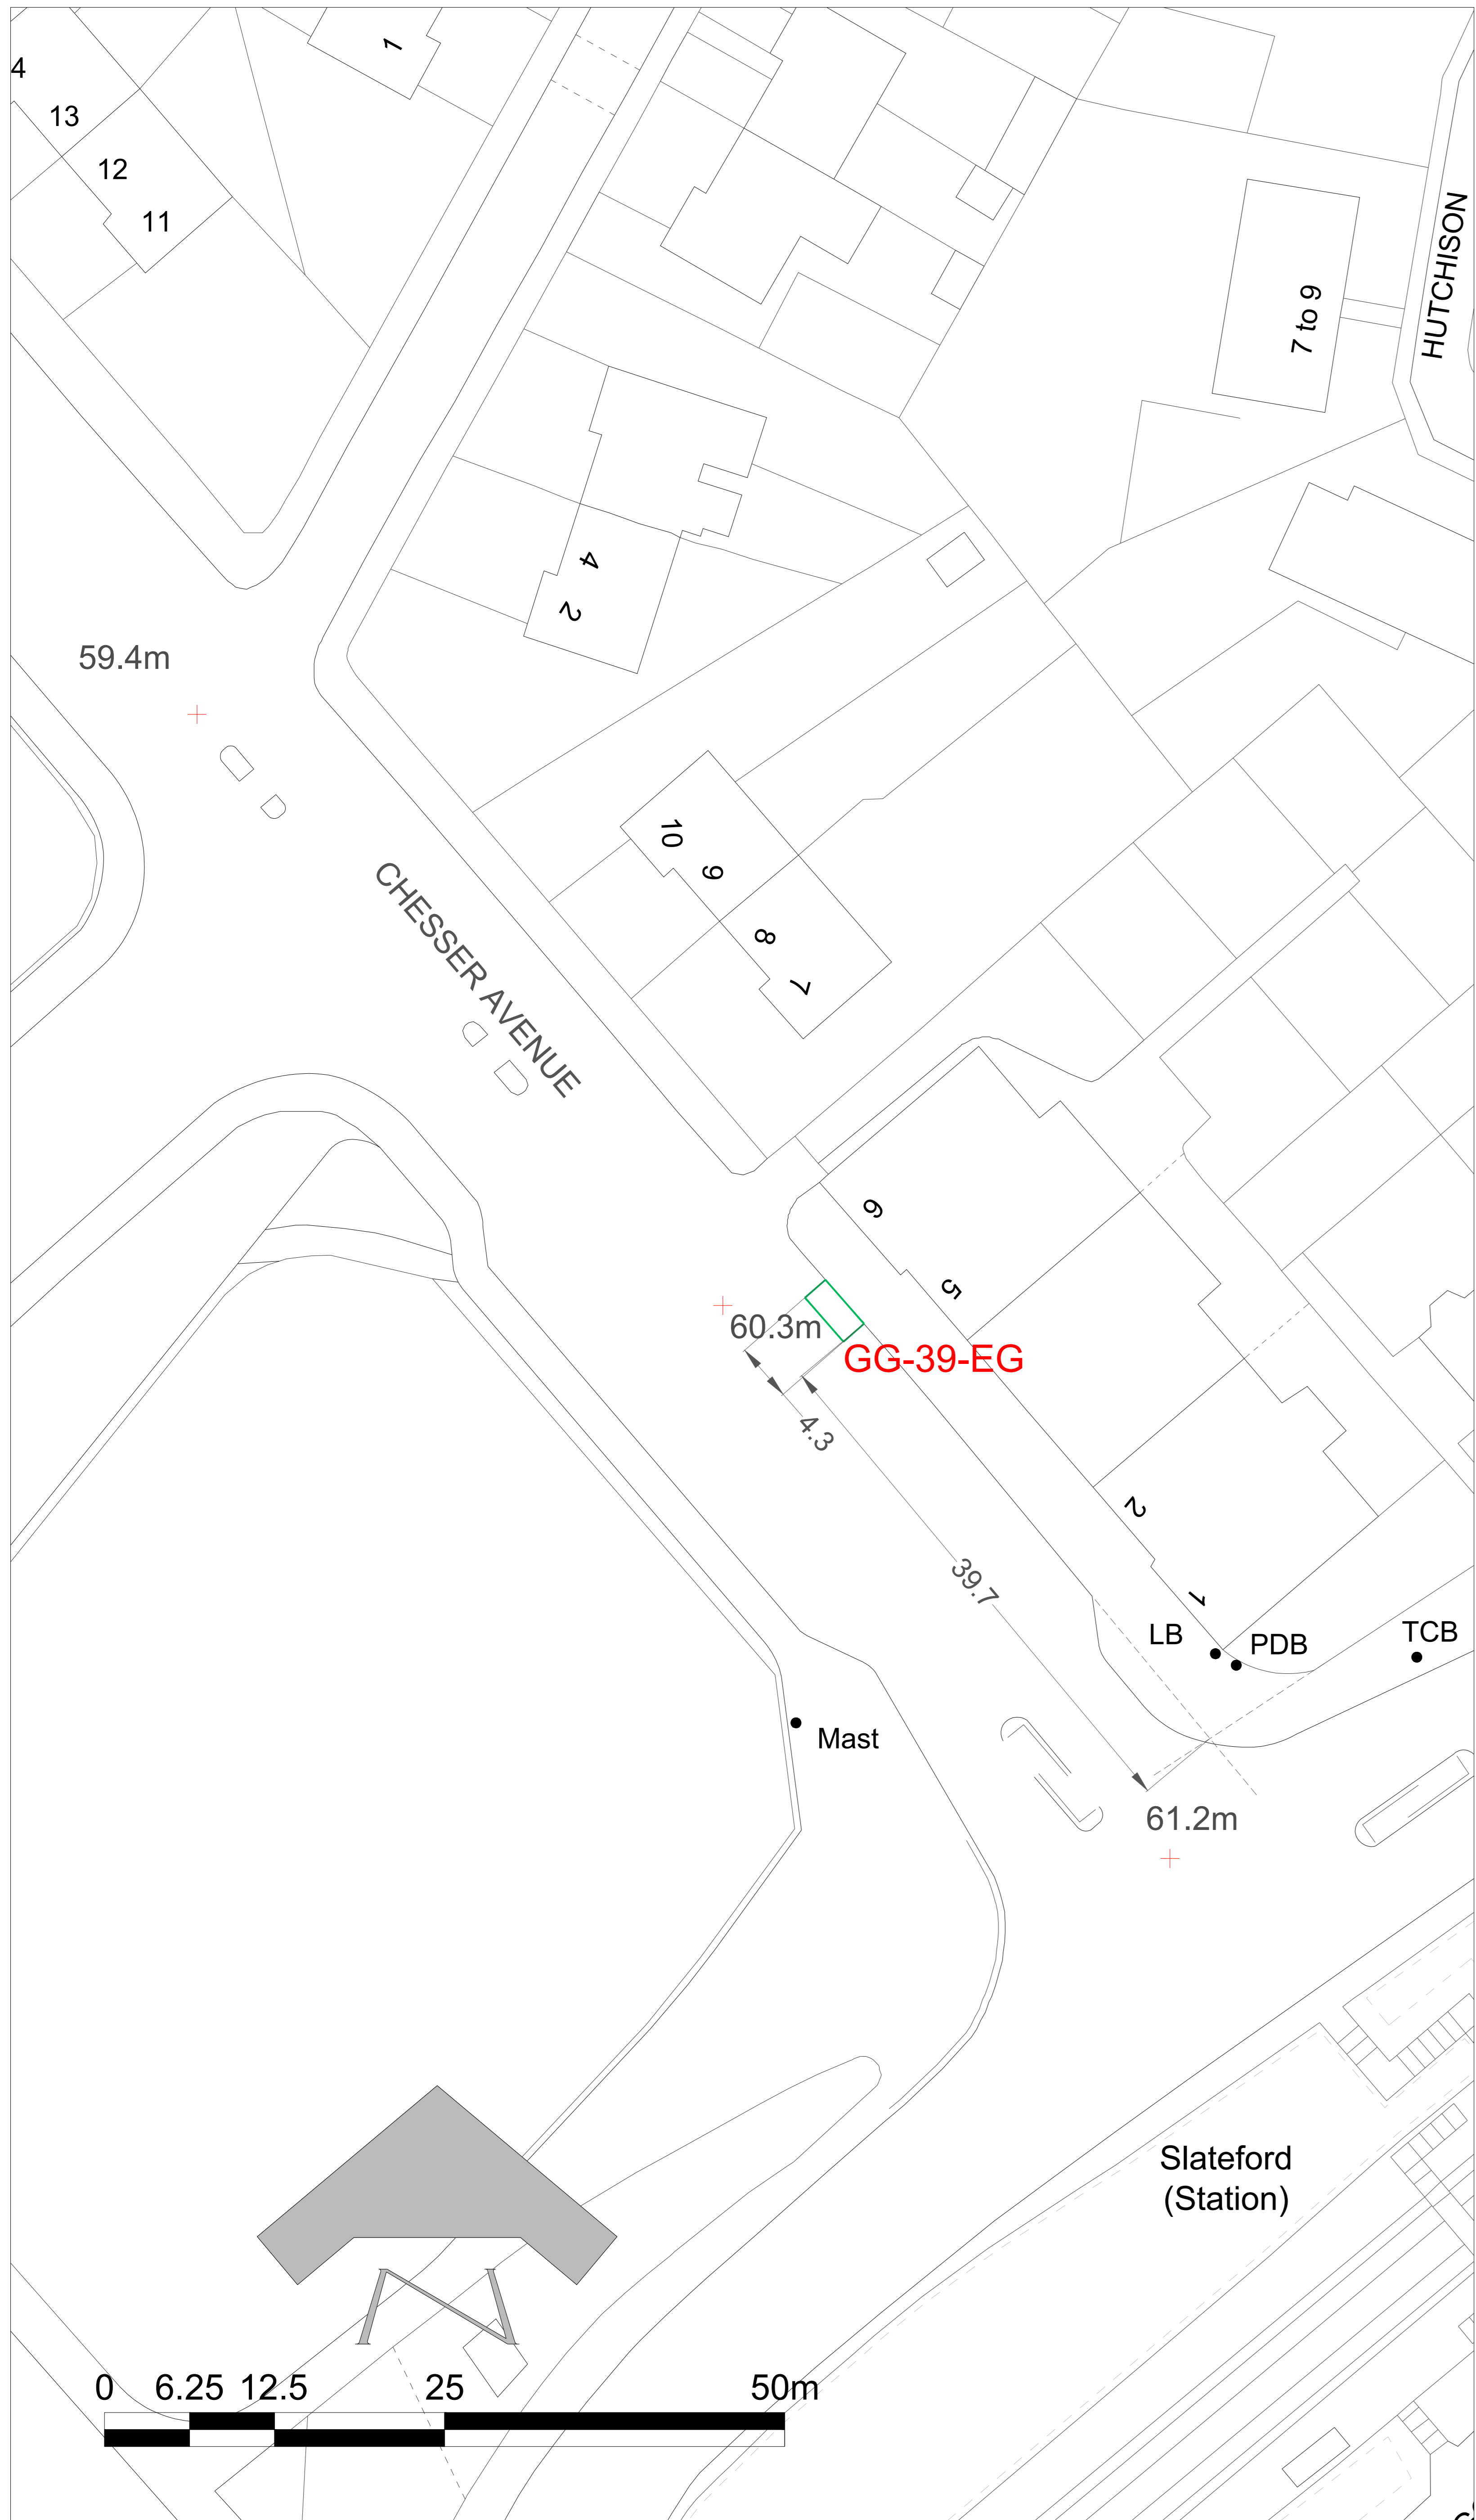

Proposed

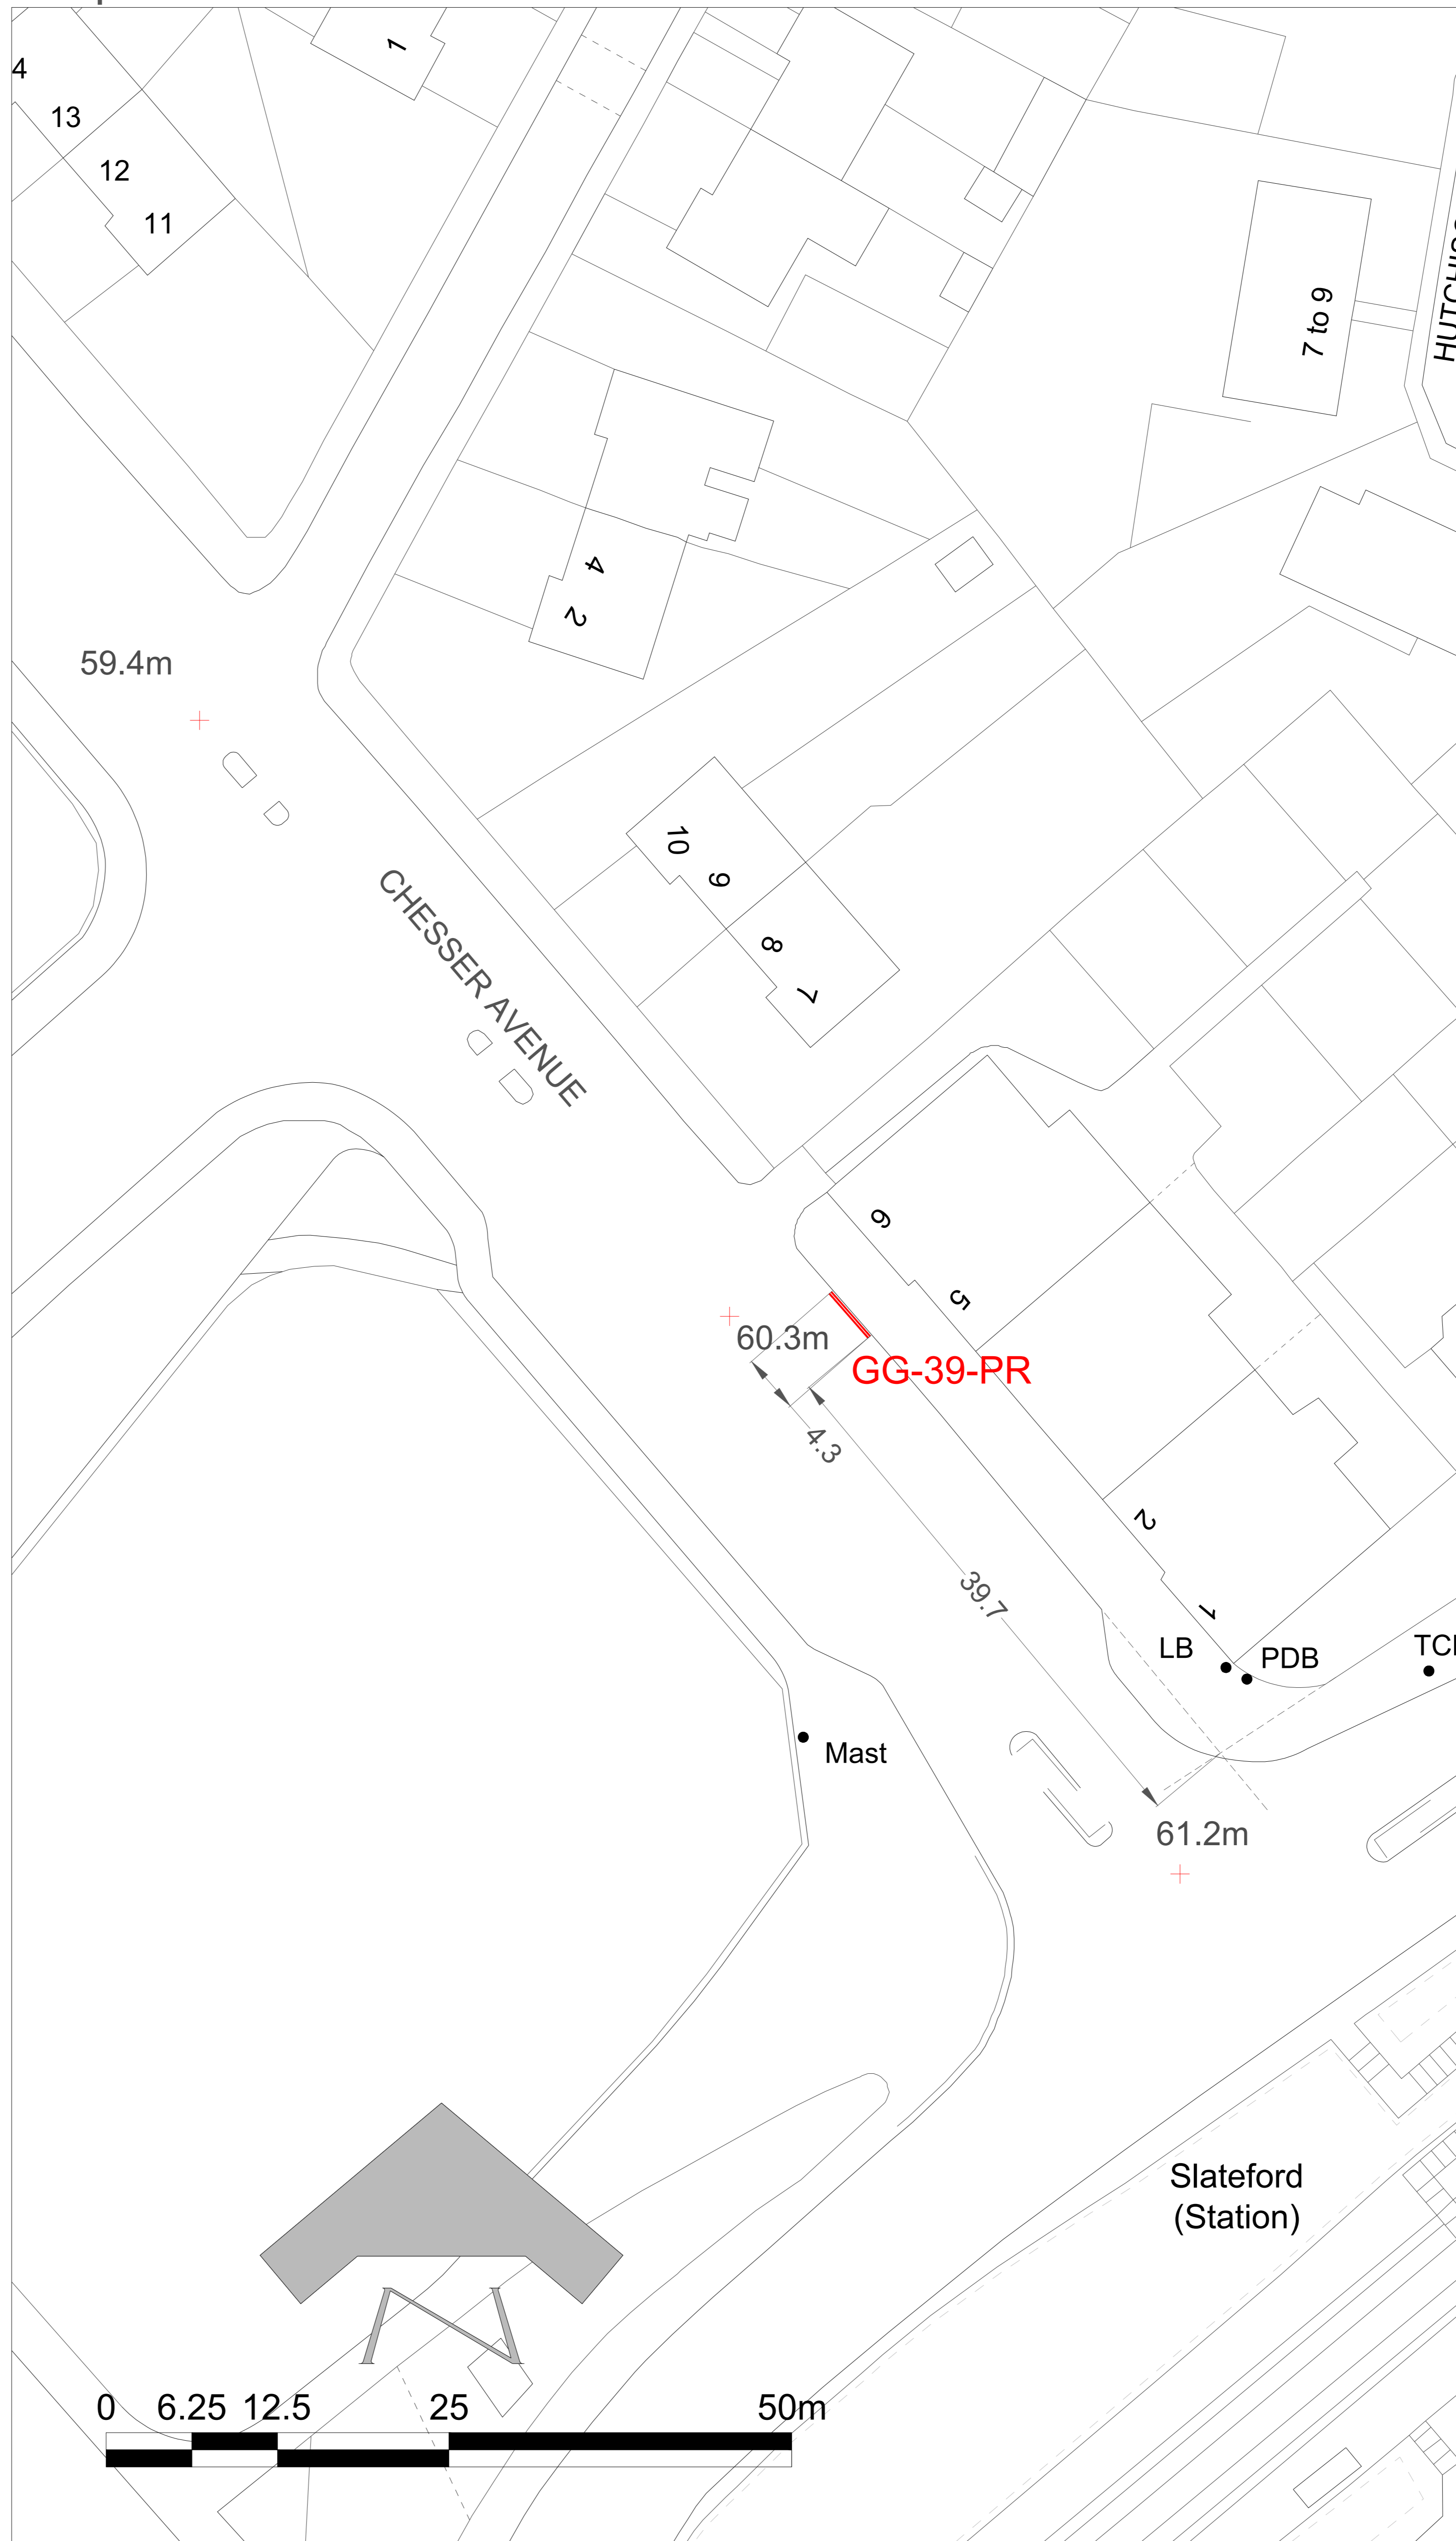

KEY

- DOUBLE YELLOW LINE (DYL)
- SINGLE RED LINE (SRL)
- DOUBLE RED LINE (DRL)
- LOADING BAY
- GREENWAY LOADING BAY
- GREENWAY PARKING BAY

This map is reproduced from Ordnance Survey material with the permission of Ordnance Survey on behalf of the Controller of Her Majesty's Stationery Office © Crown copyright. Unauthorised reproduction infringes Crown copyright and may lead to prosecution or civil proceedings.
100023420 (2015)

A	CHANGES FOLLOWING T.O. TEAM COMMENTS	MP	27/08/24	JT
REVISION	DETAILS	BY	DATE	CHECKED



The City of Edinburgh Council
Waverley Court, 4 East Market Street
Edinburgh, EH8 8BG
Telephone: 0131 200 2000

WASTE

**COMMUNAL BIN REVIEW
AMENDMENTS TO TEXT-BASED ORDERS
PAGE 2**

Date: 30/05/2024 Job No. Drawn by: MP
Scale: 1:250 @A0 Checked by: JT







Current



Proposed



KEY

-  DOUBLE YELLOW LINE (DYL)
-  SINGLE RED LINE (SRL)
-  DOUBLE RED LINE (DRL)
-  LOADING BAY
-  GREENWAY LOADING BAY
-  GREENWAY PARKING BAY

This map is reproduced from Ordnance Survey material with the permission of Ordnance Survey on behalf of the Controller of Her Majesty's Stationery Office © Crown copyright. Unauthorised reproduction infringes Crown copyright and may lead to prosecution or civil proceedings.

100023420 (2015)

A	CHANGES FOLLOWING T.O. TEAM COMMENTS	MP	27/08/24	JT
REVISION	DETAILS	BY	DATE	CHECKED

EDINBURGH
THE CITY OF EDINBURGH COUNCIL

The City of Edinburgh Council
Waverley Court, 4 East Market Street
Edinburgh, EH8 8BG
Telephone: 0131 200 2000


WASTE

COMMUNAL BIN REVIEW
AMENDMENTS TO TEXT-BASED ORDERS
PAGE 3


Date: 30/05/2024	Job No.	Drawn by: MP
Scale: 1:250 @A0		Checked by: JT

DRG. NO. WCBR-GW TRO



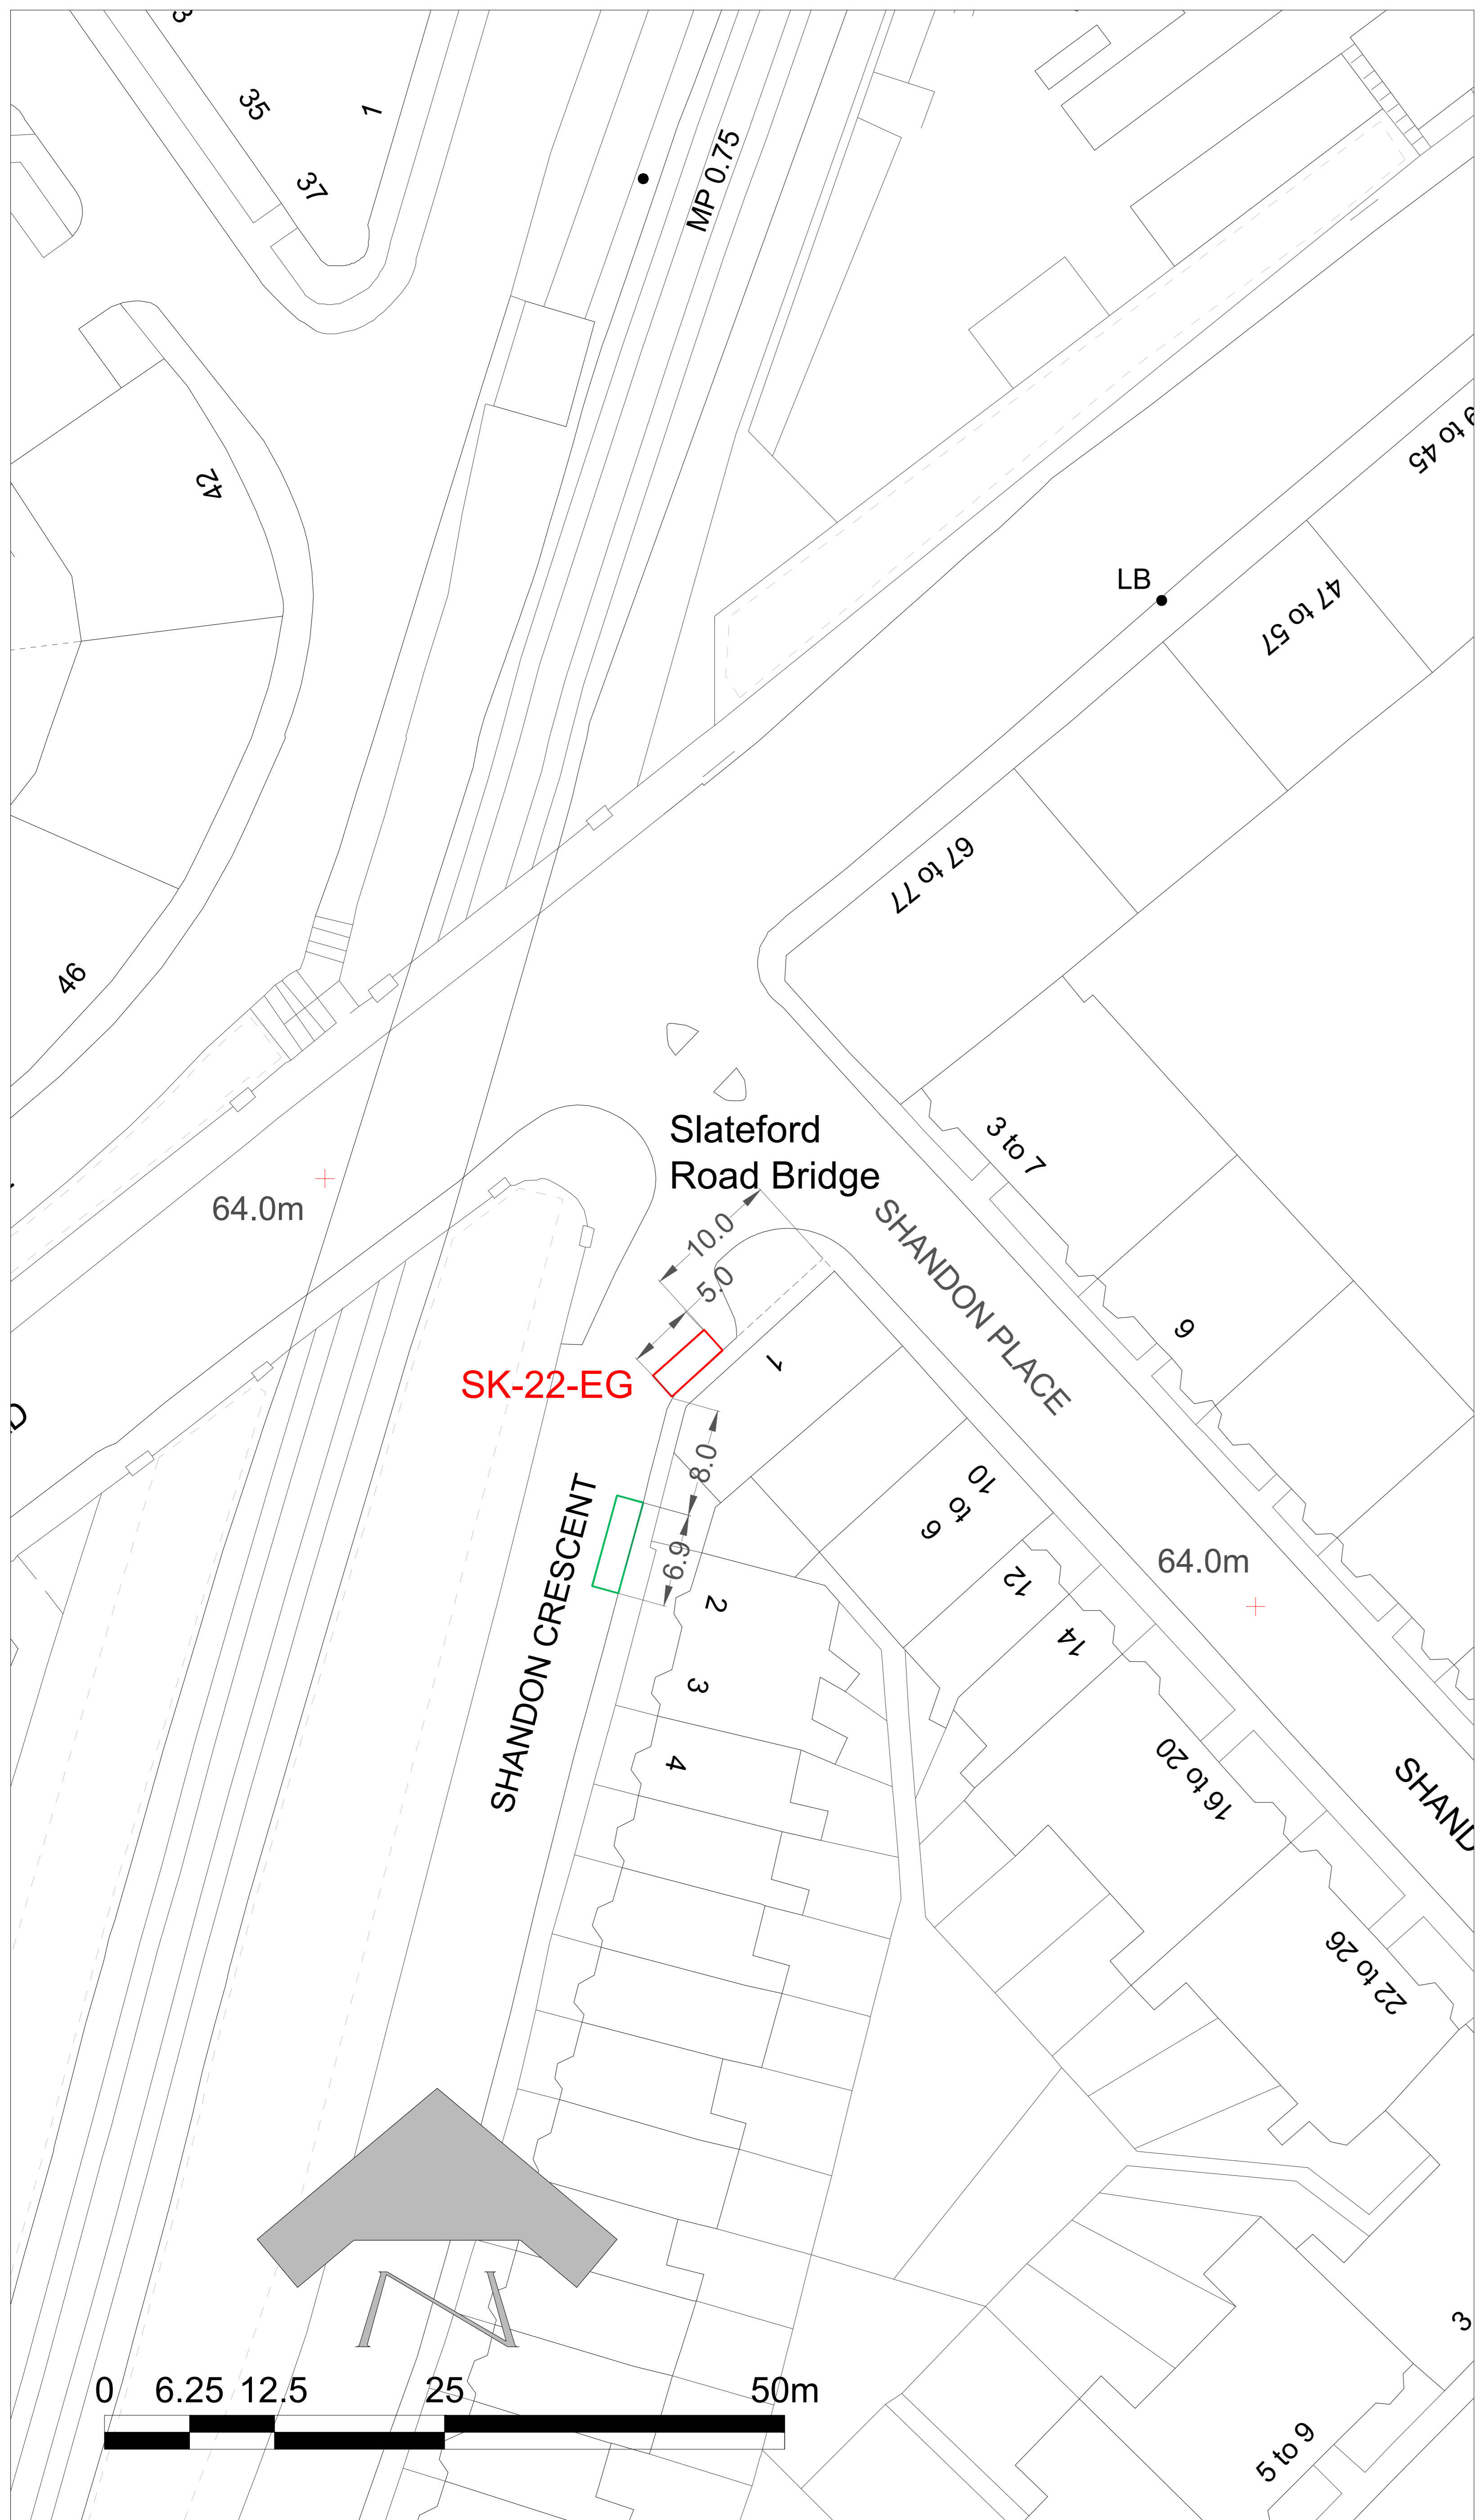

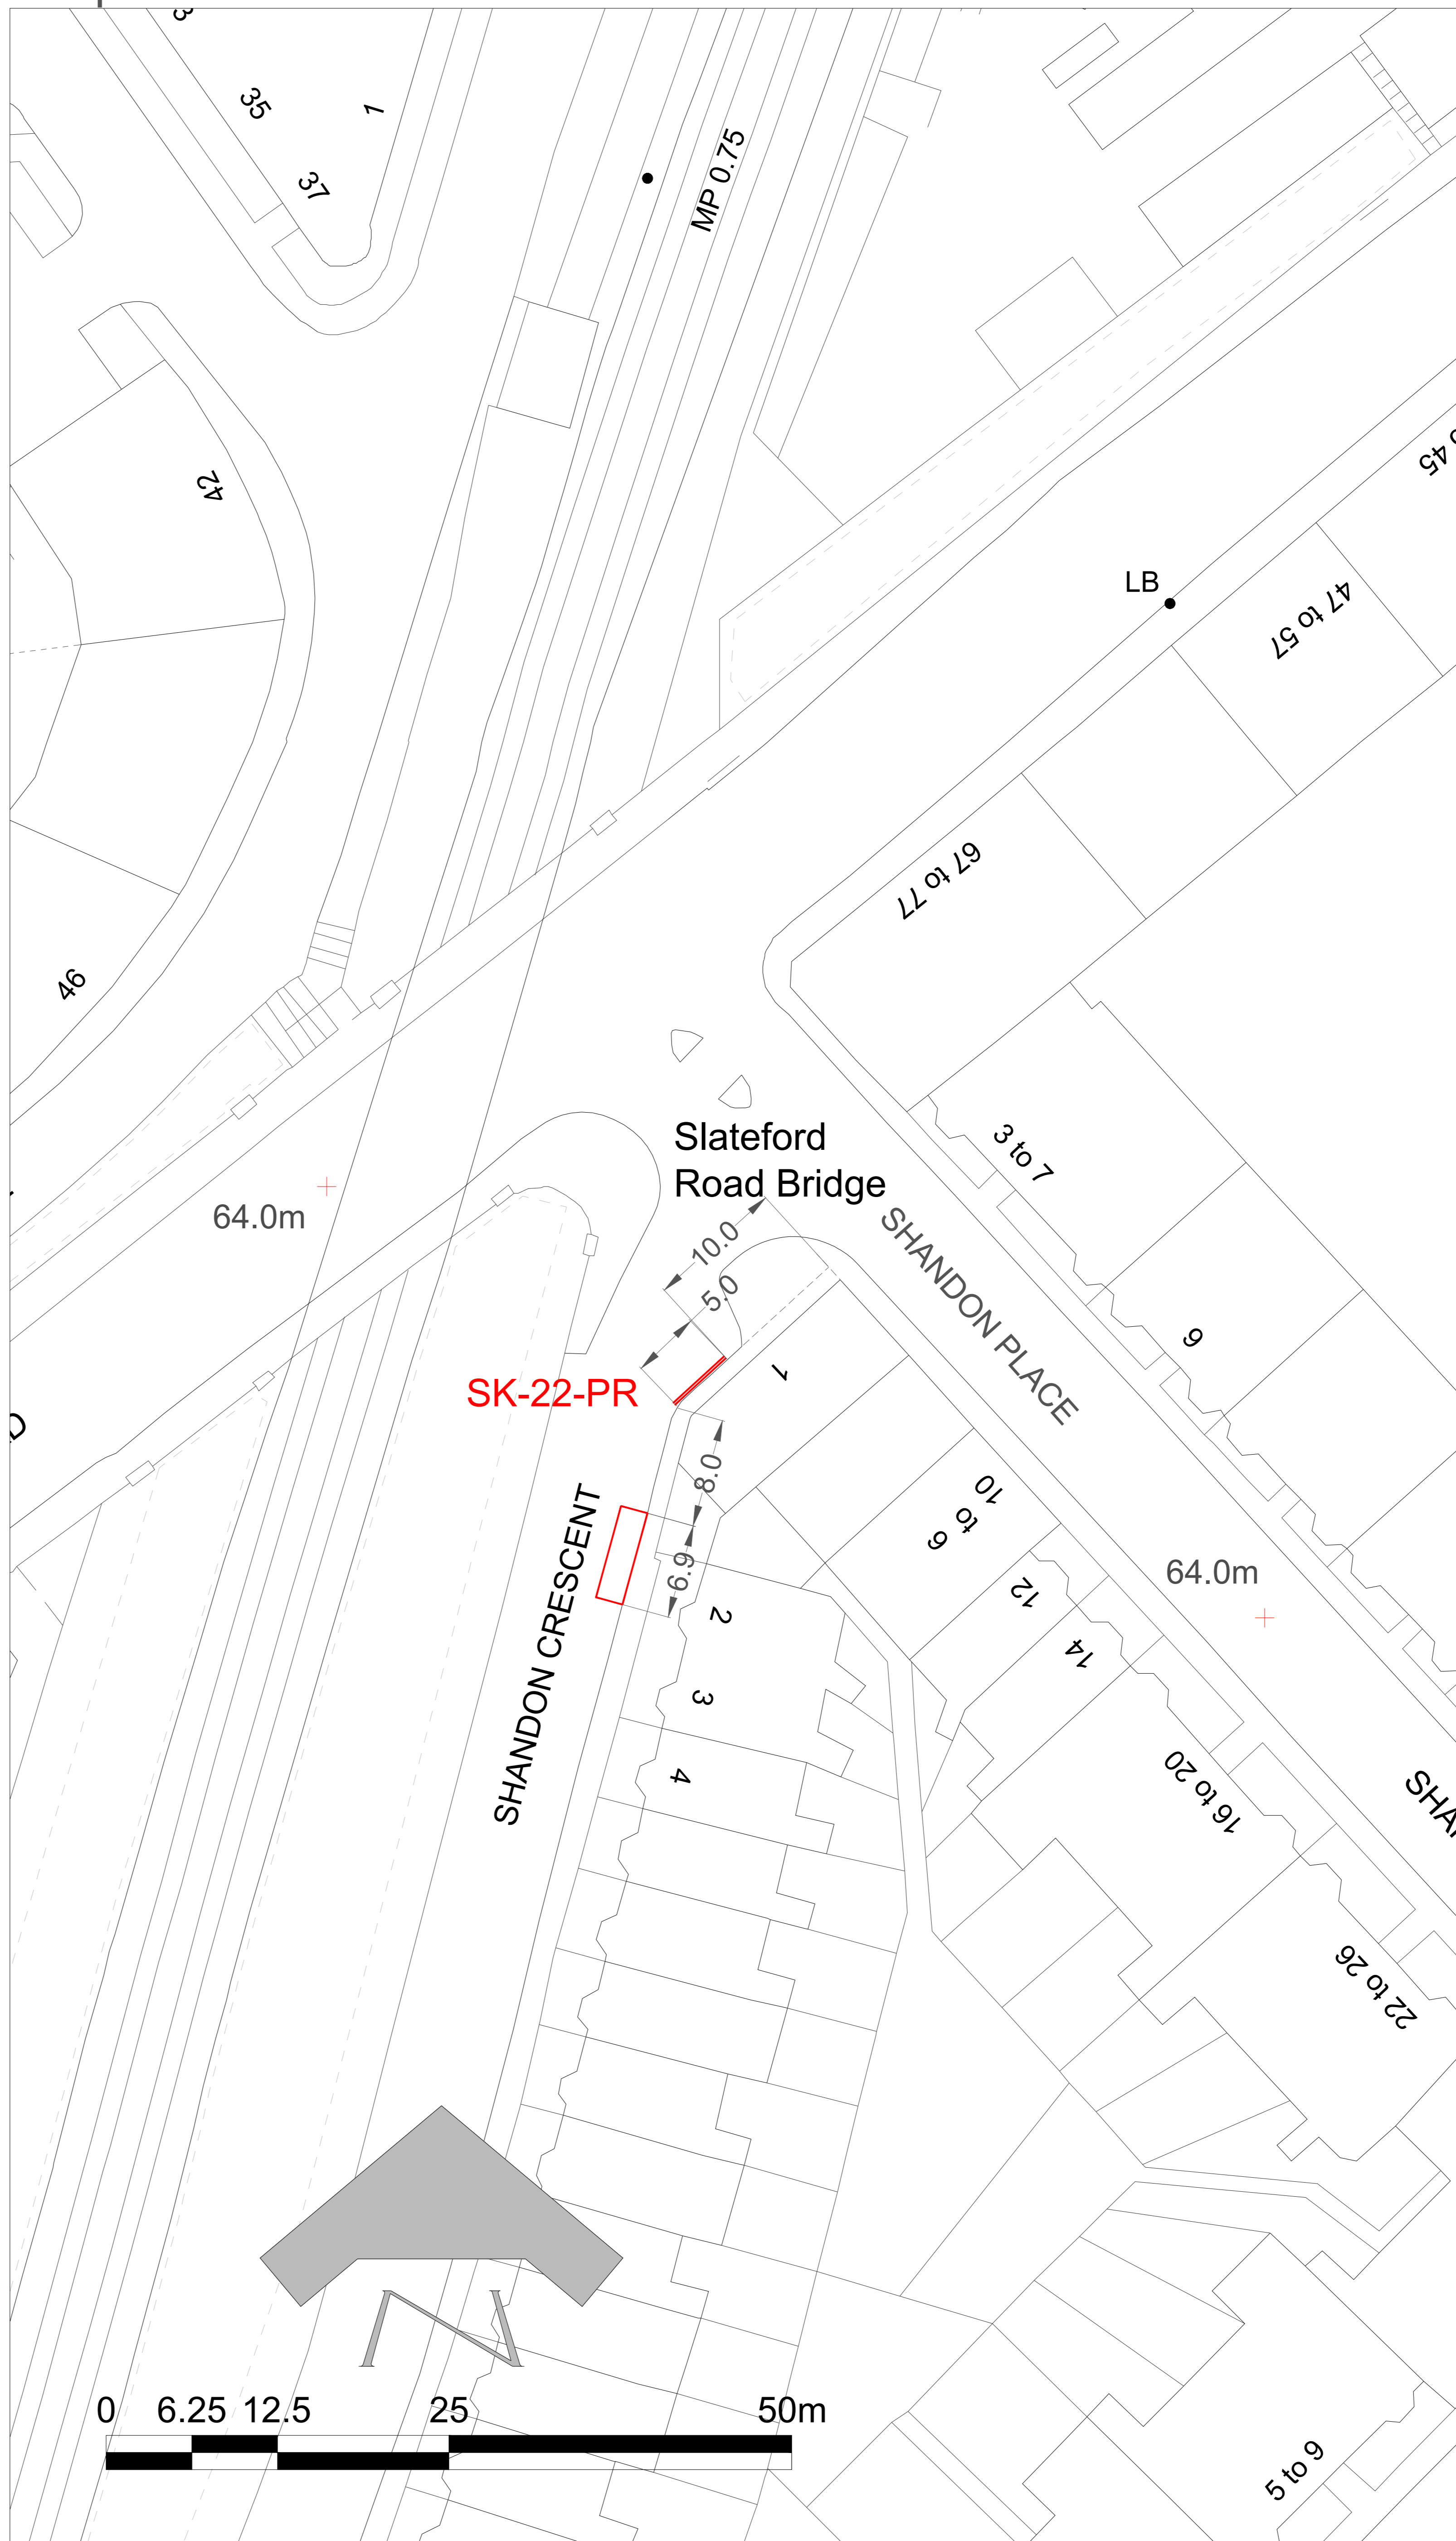

Current



Proposed



KEY

-  DOUBLE YELLOW LINE (DYL)
-  SINGLE RED LINE (SRL)
-  DOUBLE RED LINE (DRL)
-  LOADING BAY
-  GREENWAY LOADING BAY
-  GREENWAY PARKING BAY

This map is reproduced from Ordnance Survey material with the permission of Ordnance Survey on behalf of the Controller of Her Majesty's Stationery Office © Crown copyright. Unauthorised reproduction infringes Crown copyright and may lead to prosecution or civil proceedings.

100023420 (2015)

A	CHANGES FOLLOWING T.O. TEAM COMMENTS	MP	27/08/24	JT
REVISION	DETAILS	BY	DATE	CHECKED

EDINBURGH
THE CITY OF EDINBURGH COUNCIL

The City of Edinburgh Council
Waverley Court, 4 East Market Street
Edinburgh, EH8 8BG
Telephone: 0131 200 2000

WASTE

COMMUNAL BIN REVIEW
AMENDMENTS TO TEXT-BASED ORDERS

PAGE 4

Date: 30/05/2024
Scale: 1:250 @A0


Job No.
Checked by: JT

Drawn by: MP





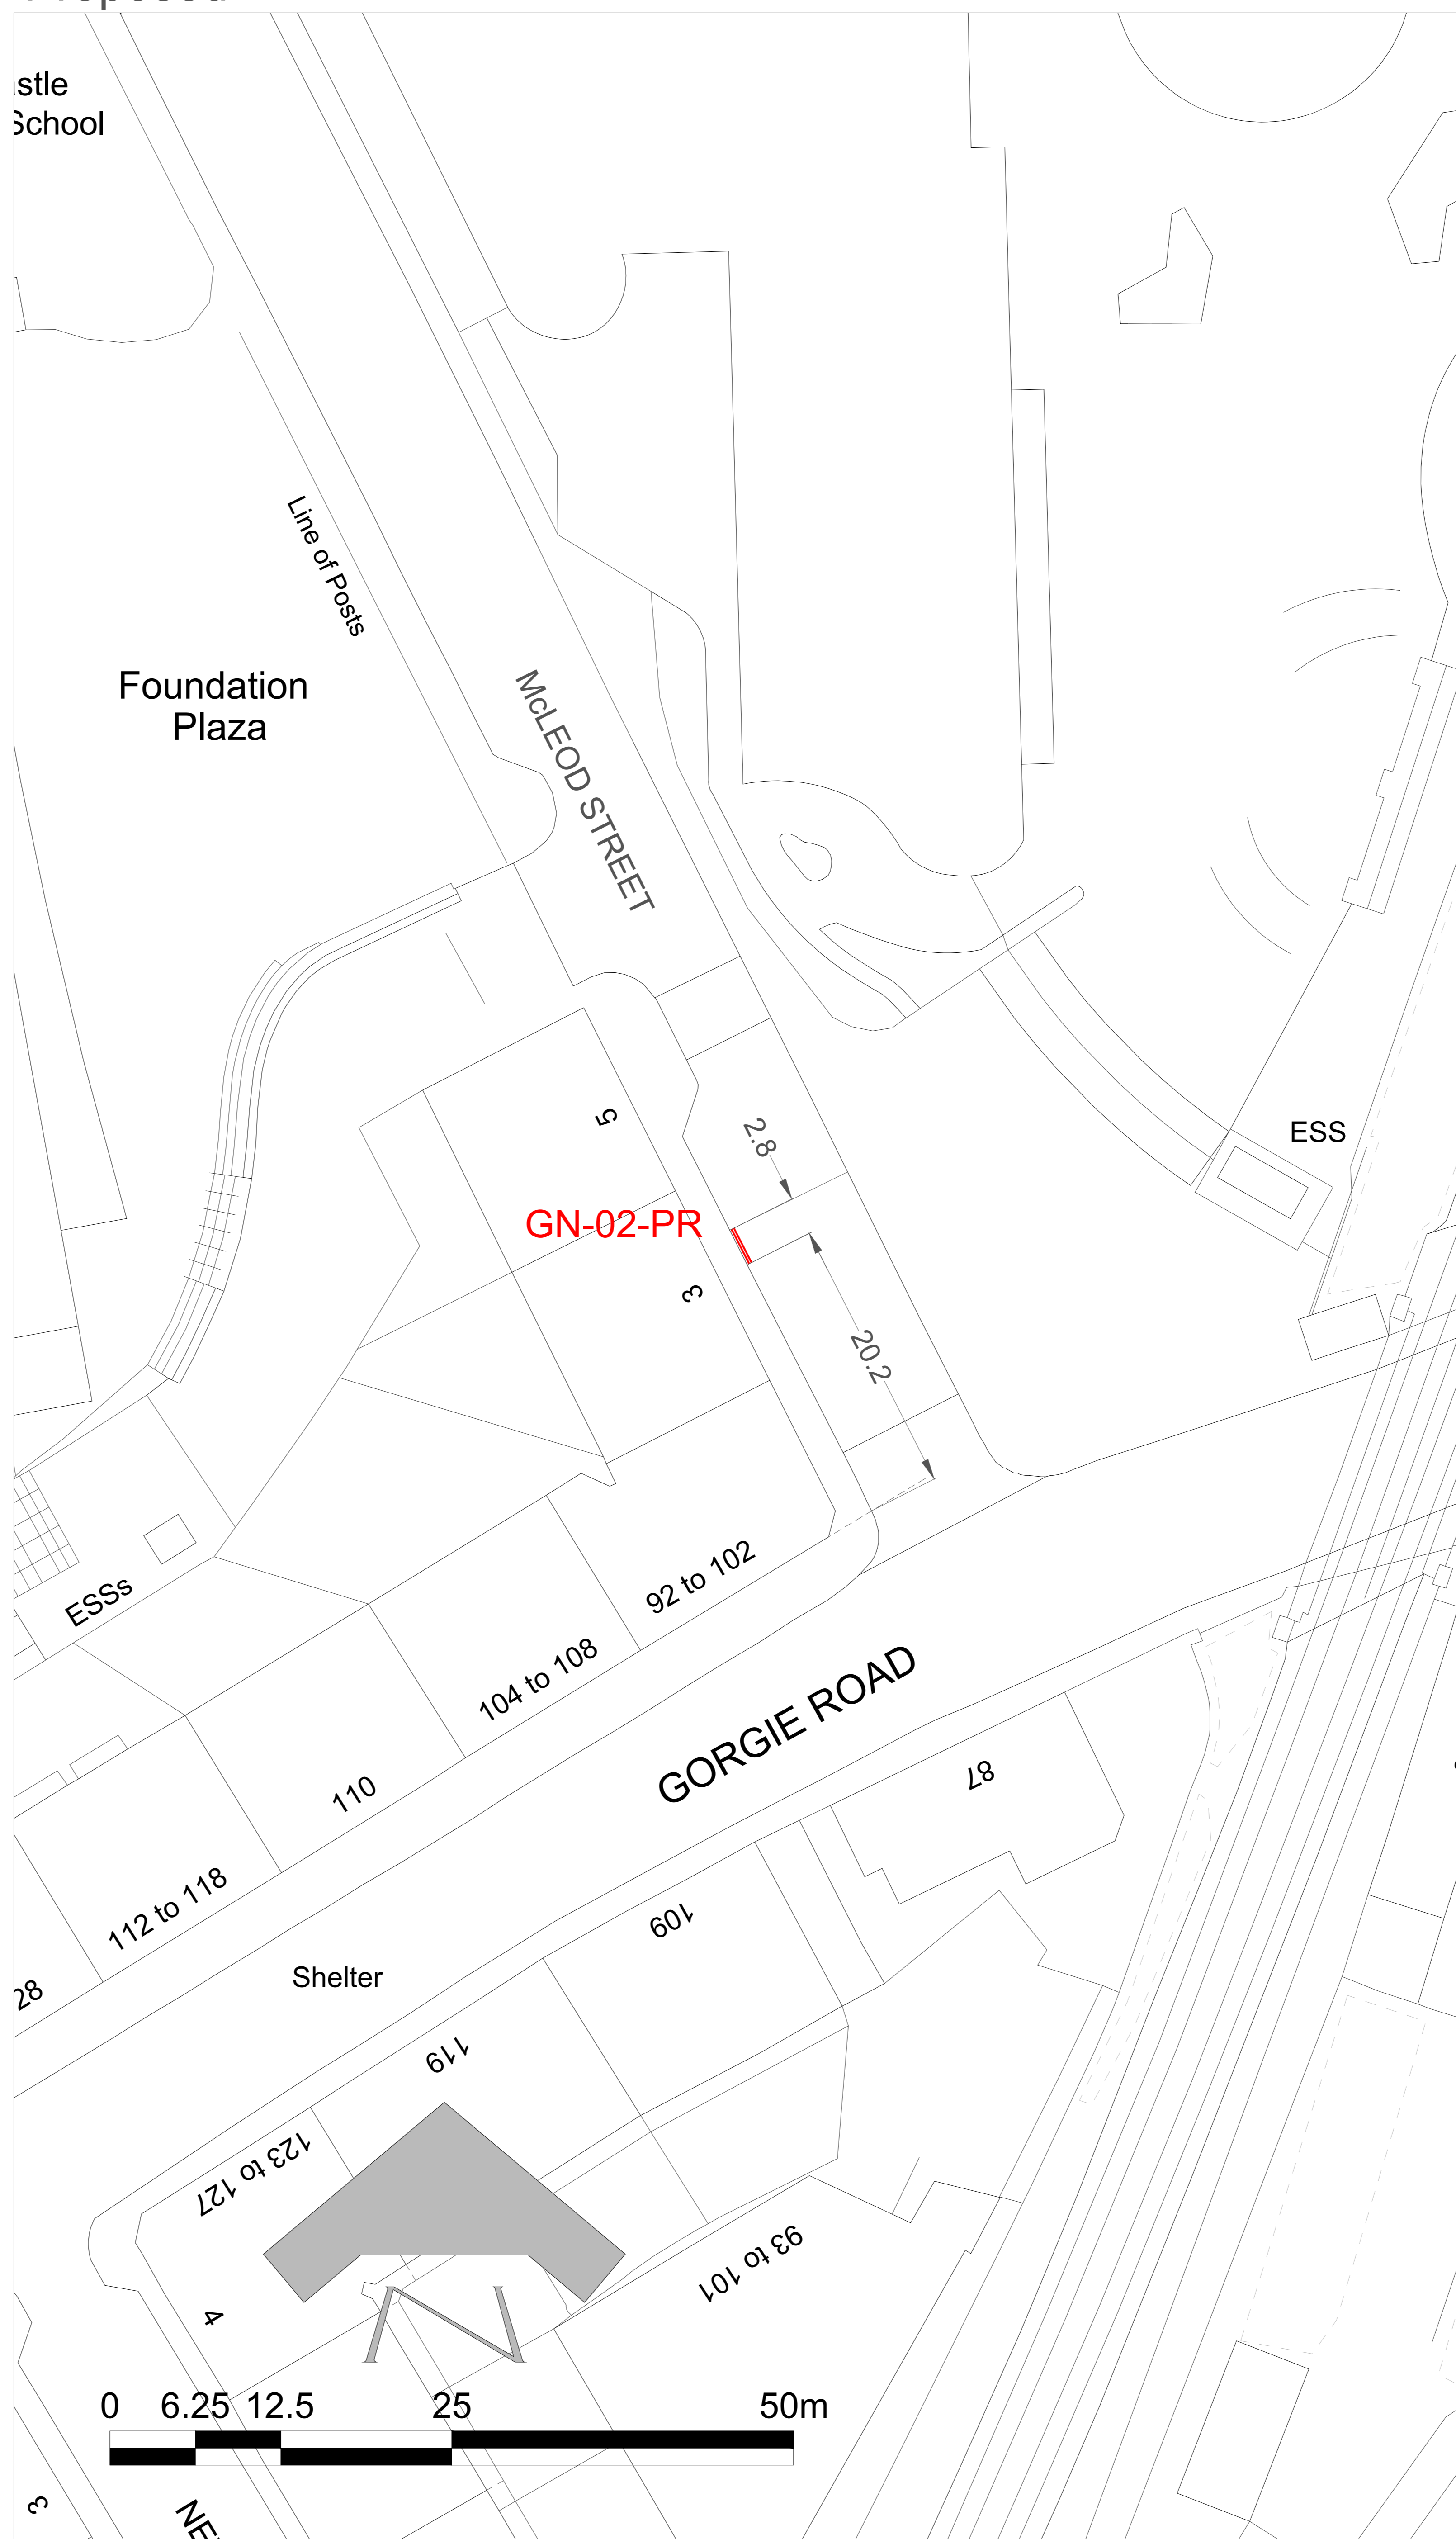

Current



Proposed



KEY

-  DOUBLE YELLOW LINE (DYL)
-  SINGLE RED LINE (SRL)
-  DOUBLE RED LINE (DRL)
-  LOADING BAY
-  GREENWAY LOADING BAY
-  GREENWAY PARKING BAY

This map is reproduced from Ordnance Survey material with the permission of Ordnance Survey on behalf of the Controller of Her Majesty's Stationery Office © Crown copyright. Unauthorised reproduction infringes Crown copyright and may lead to prosecution or civil proceedings.

100023420 (2015)

A	CHANGES FOLLOWING T.O. TEAM COMMENTS	MP	27/08/24	JT
REVISION	DETAILS	BY	DATE	CHECKED

EDINBURGH
THE CITY OF EDINBURGH COUNCIL

The City of Edinburgh Council
Waverley Court, 4 East Market Street
Edinburgh, EH8 8BG
Telephone: 0131 200 2000


WASTE

COMMUNAL BIN REVIEW
AMENDMENTS TO TEXT-BASED ORDERS
PAGE 5


Date: 30/05/2024	Job No.	Drawn by: MP
Scale: 1:250 @A0		Checked by: JT

DRG. NO. WCBR-GW TRO



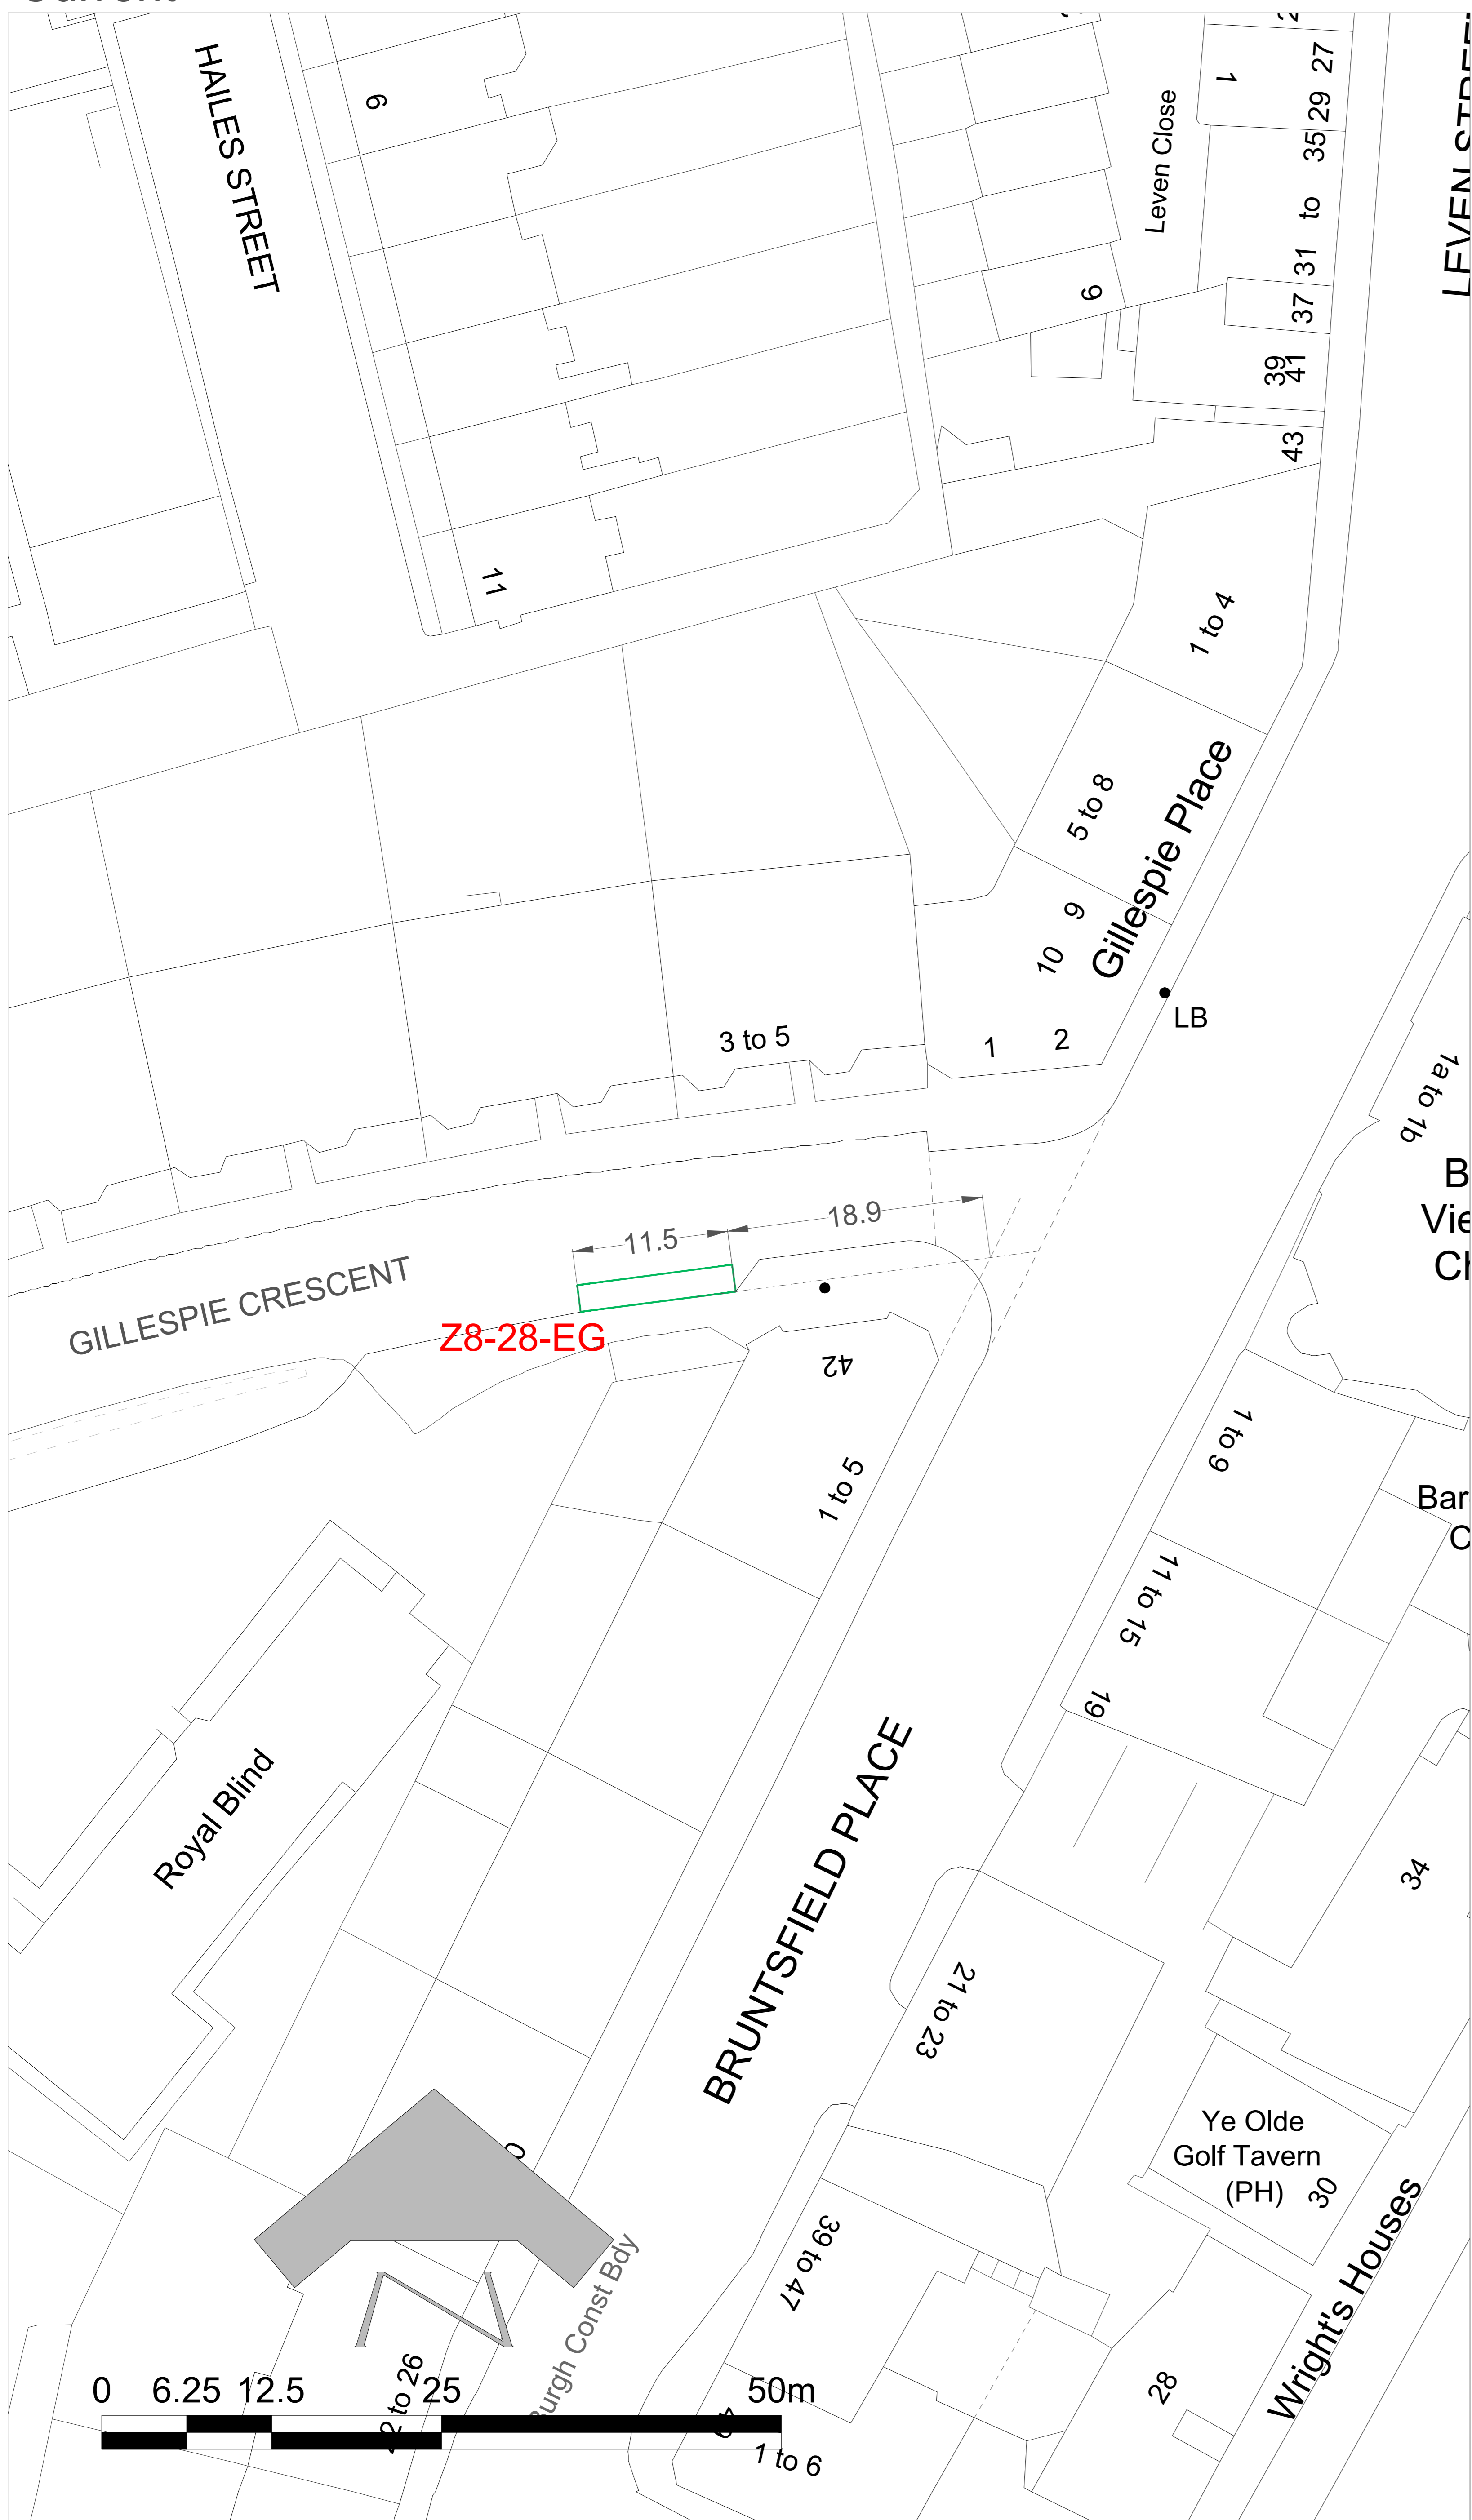

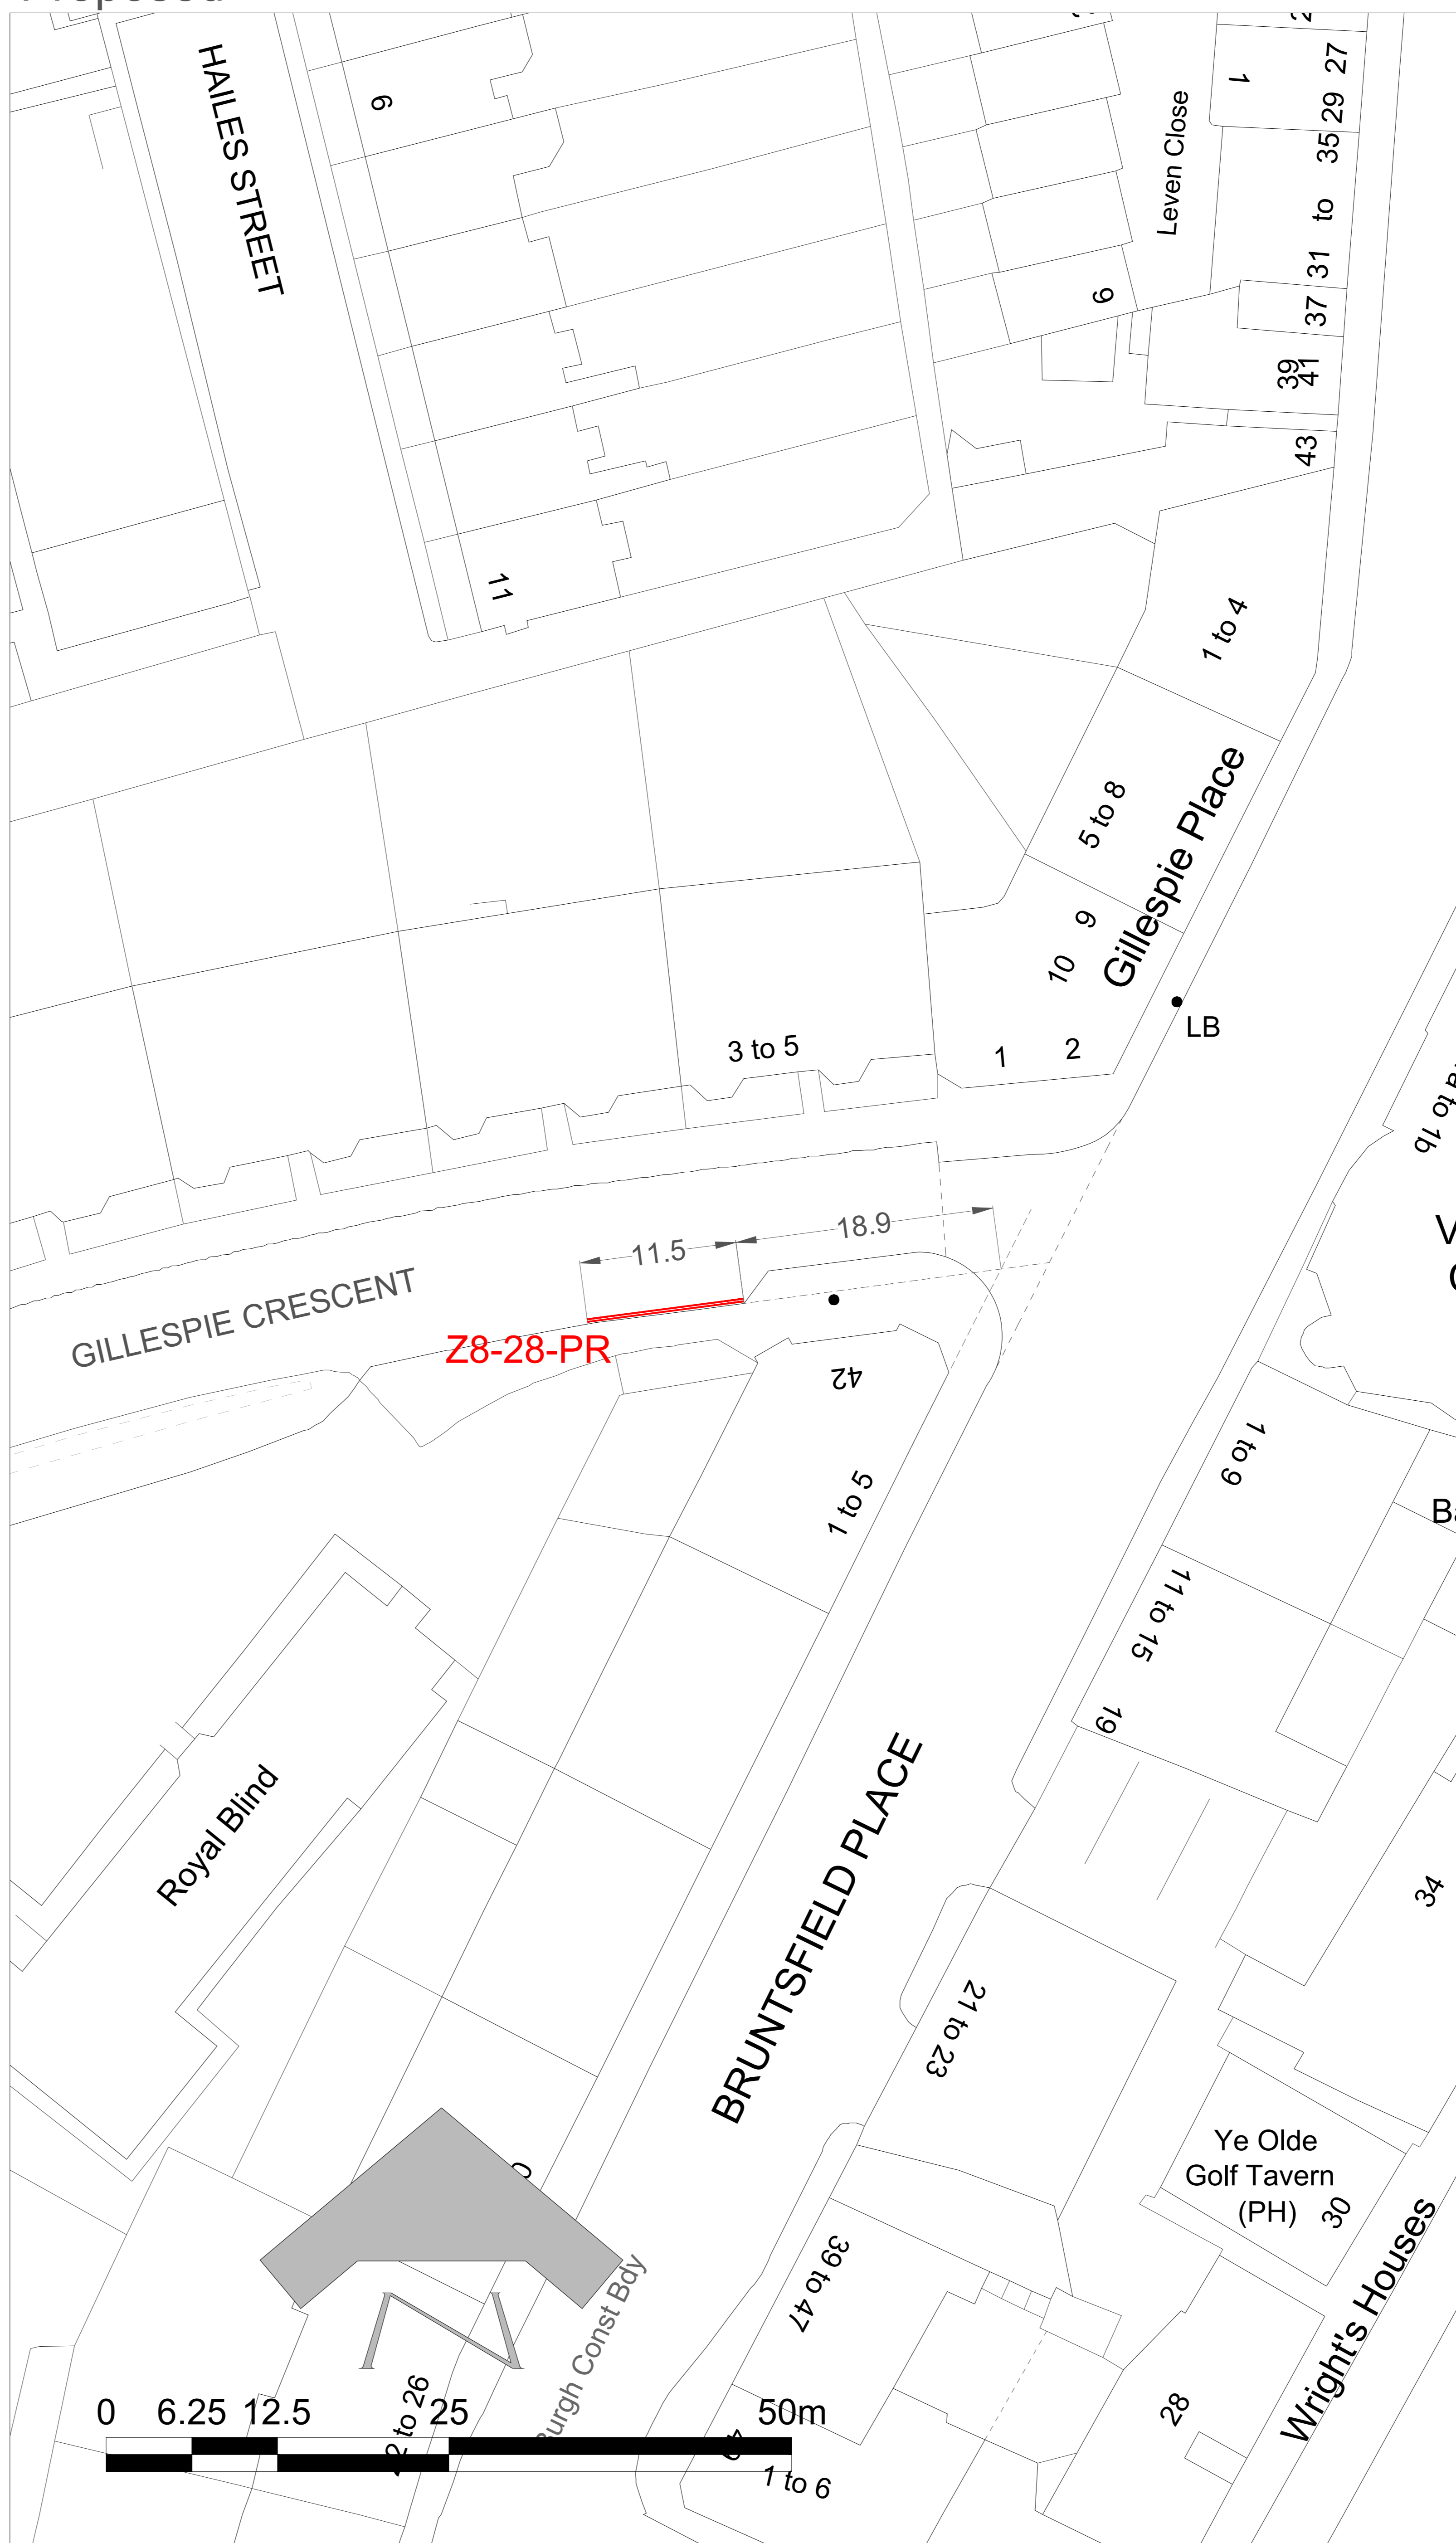

Current



Proposed



KEY

-  DOUBLE YELLOW LINE (DYL)
-  SINGLE RED LINE (SRL)
-  DOUBLE RED LINE (DRL)
-  LOADING BAY
-  GREENWAY LOADING BAY
-  GREENWAY PARKING BAY

This map is reproduced from Ordnance Survey material with the permission of Ordnance Survey on behalf of the Controller of Her Majesty's Stationery Office © Crown copyright. Unauthorised reproduction infringes Crown copyright and may lead to prosecution or civil proceedings.

100023420 (2015)

A	CHANGES FOLLOWING T.O. TEAM COMMENTS	MP	27/08/24	JT
REVISION	DETAILS	BY	DATE	CHECKED

EDINBURGH
THE CITY OF EDINBURGH COUNCIL

The City of Edinburgh Council
Waverley Court, 4 East Market Street
Edinburgh, EH8 8BG
Telephone: 0131 200 2000


WASTE

COMMUNAL BIN REVIEW
AMENDMENTS TO TEXT-BASED ORDERS
PAGE 7


Date: 30/05/2024	Job No.	Drawn by: MP
Scale: 1:250 @A0		Checked by: JT

DRG. NO. WCBR-GW TRO



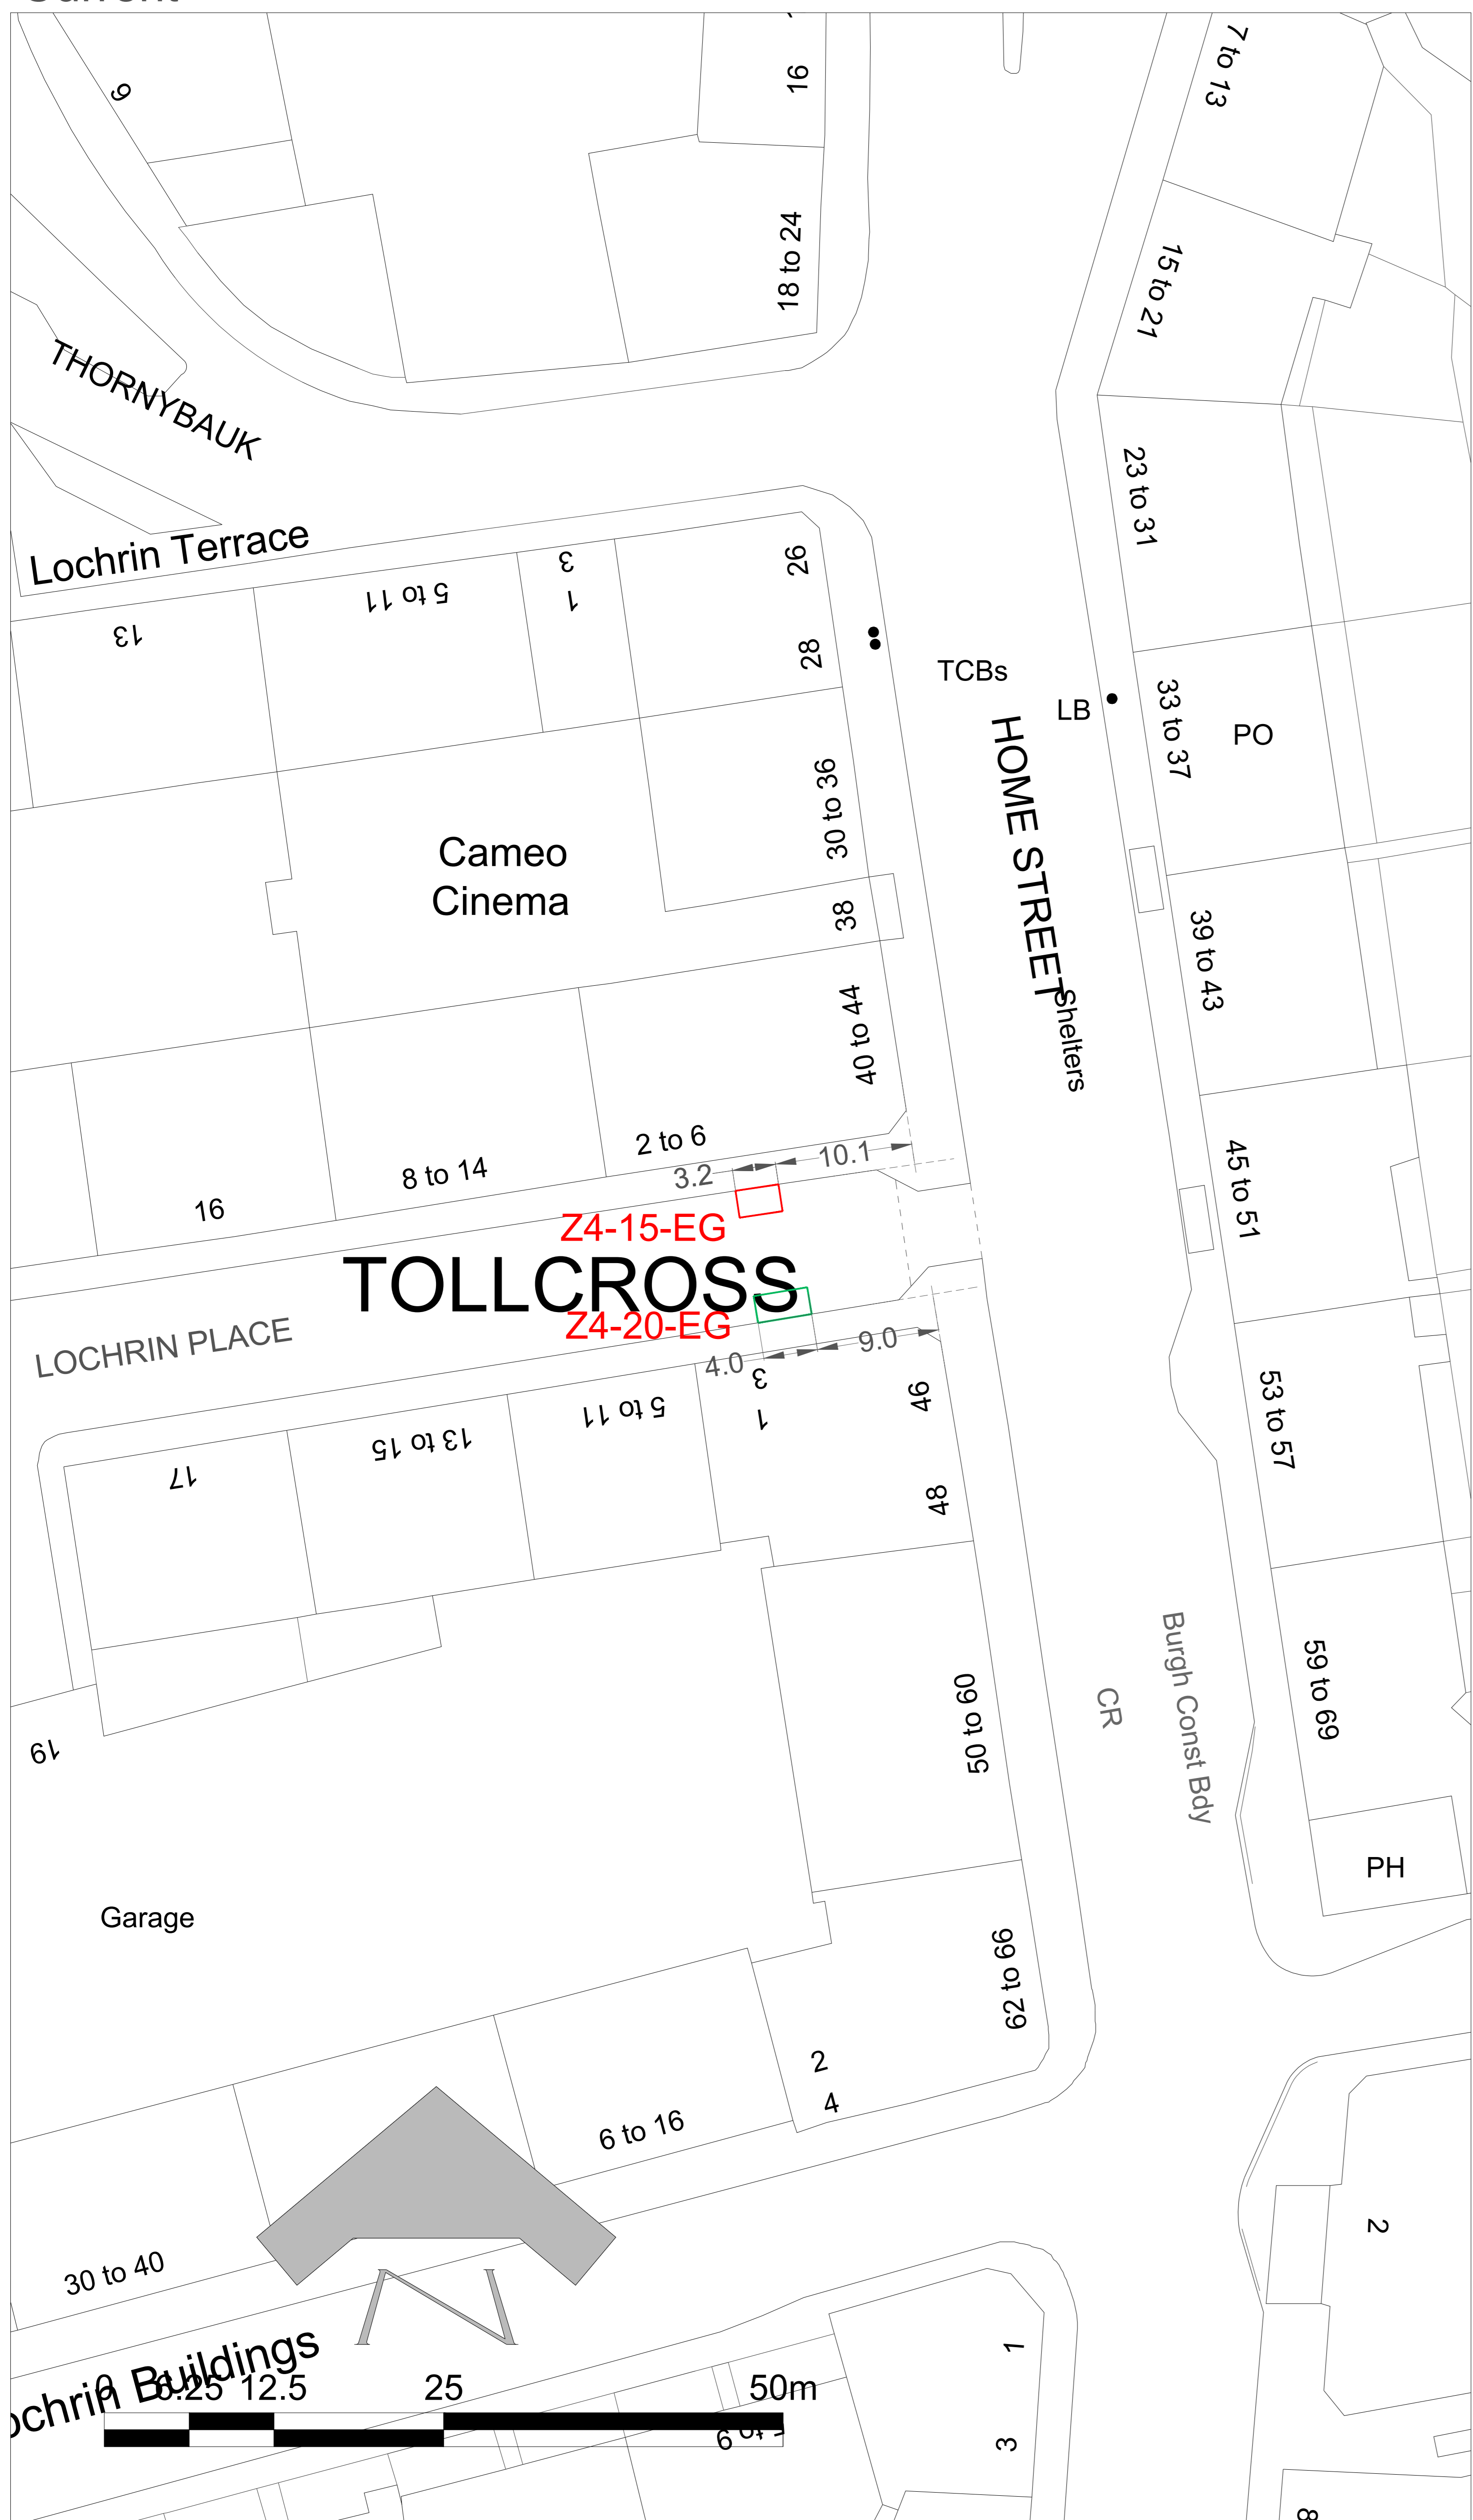

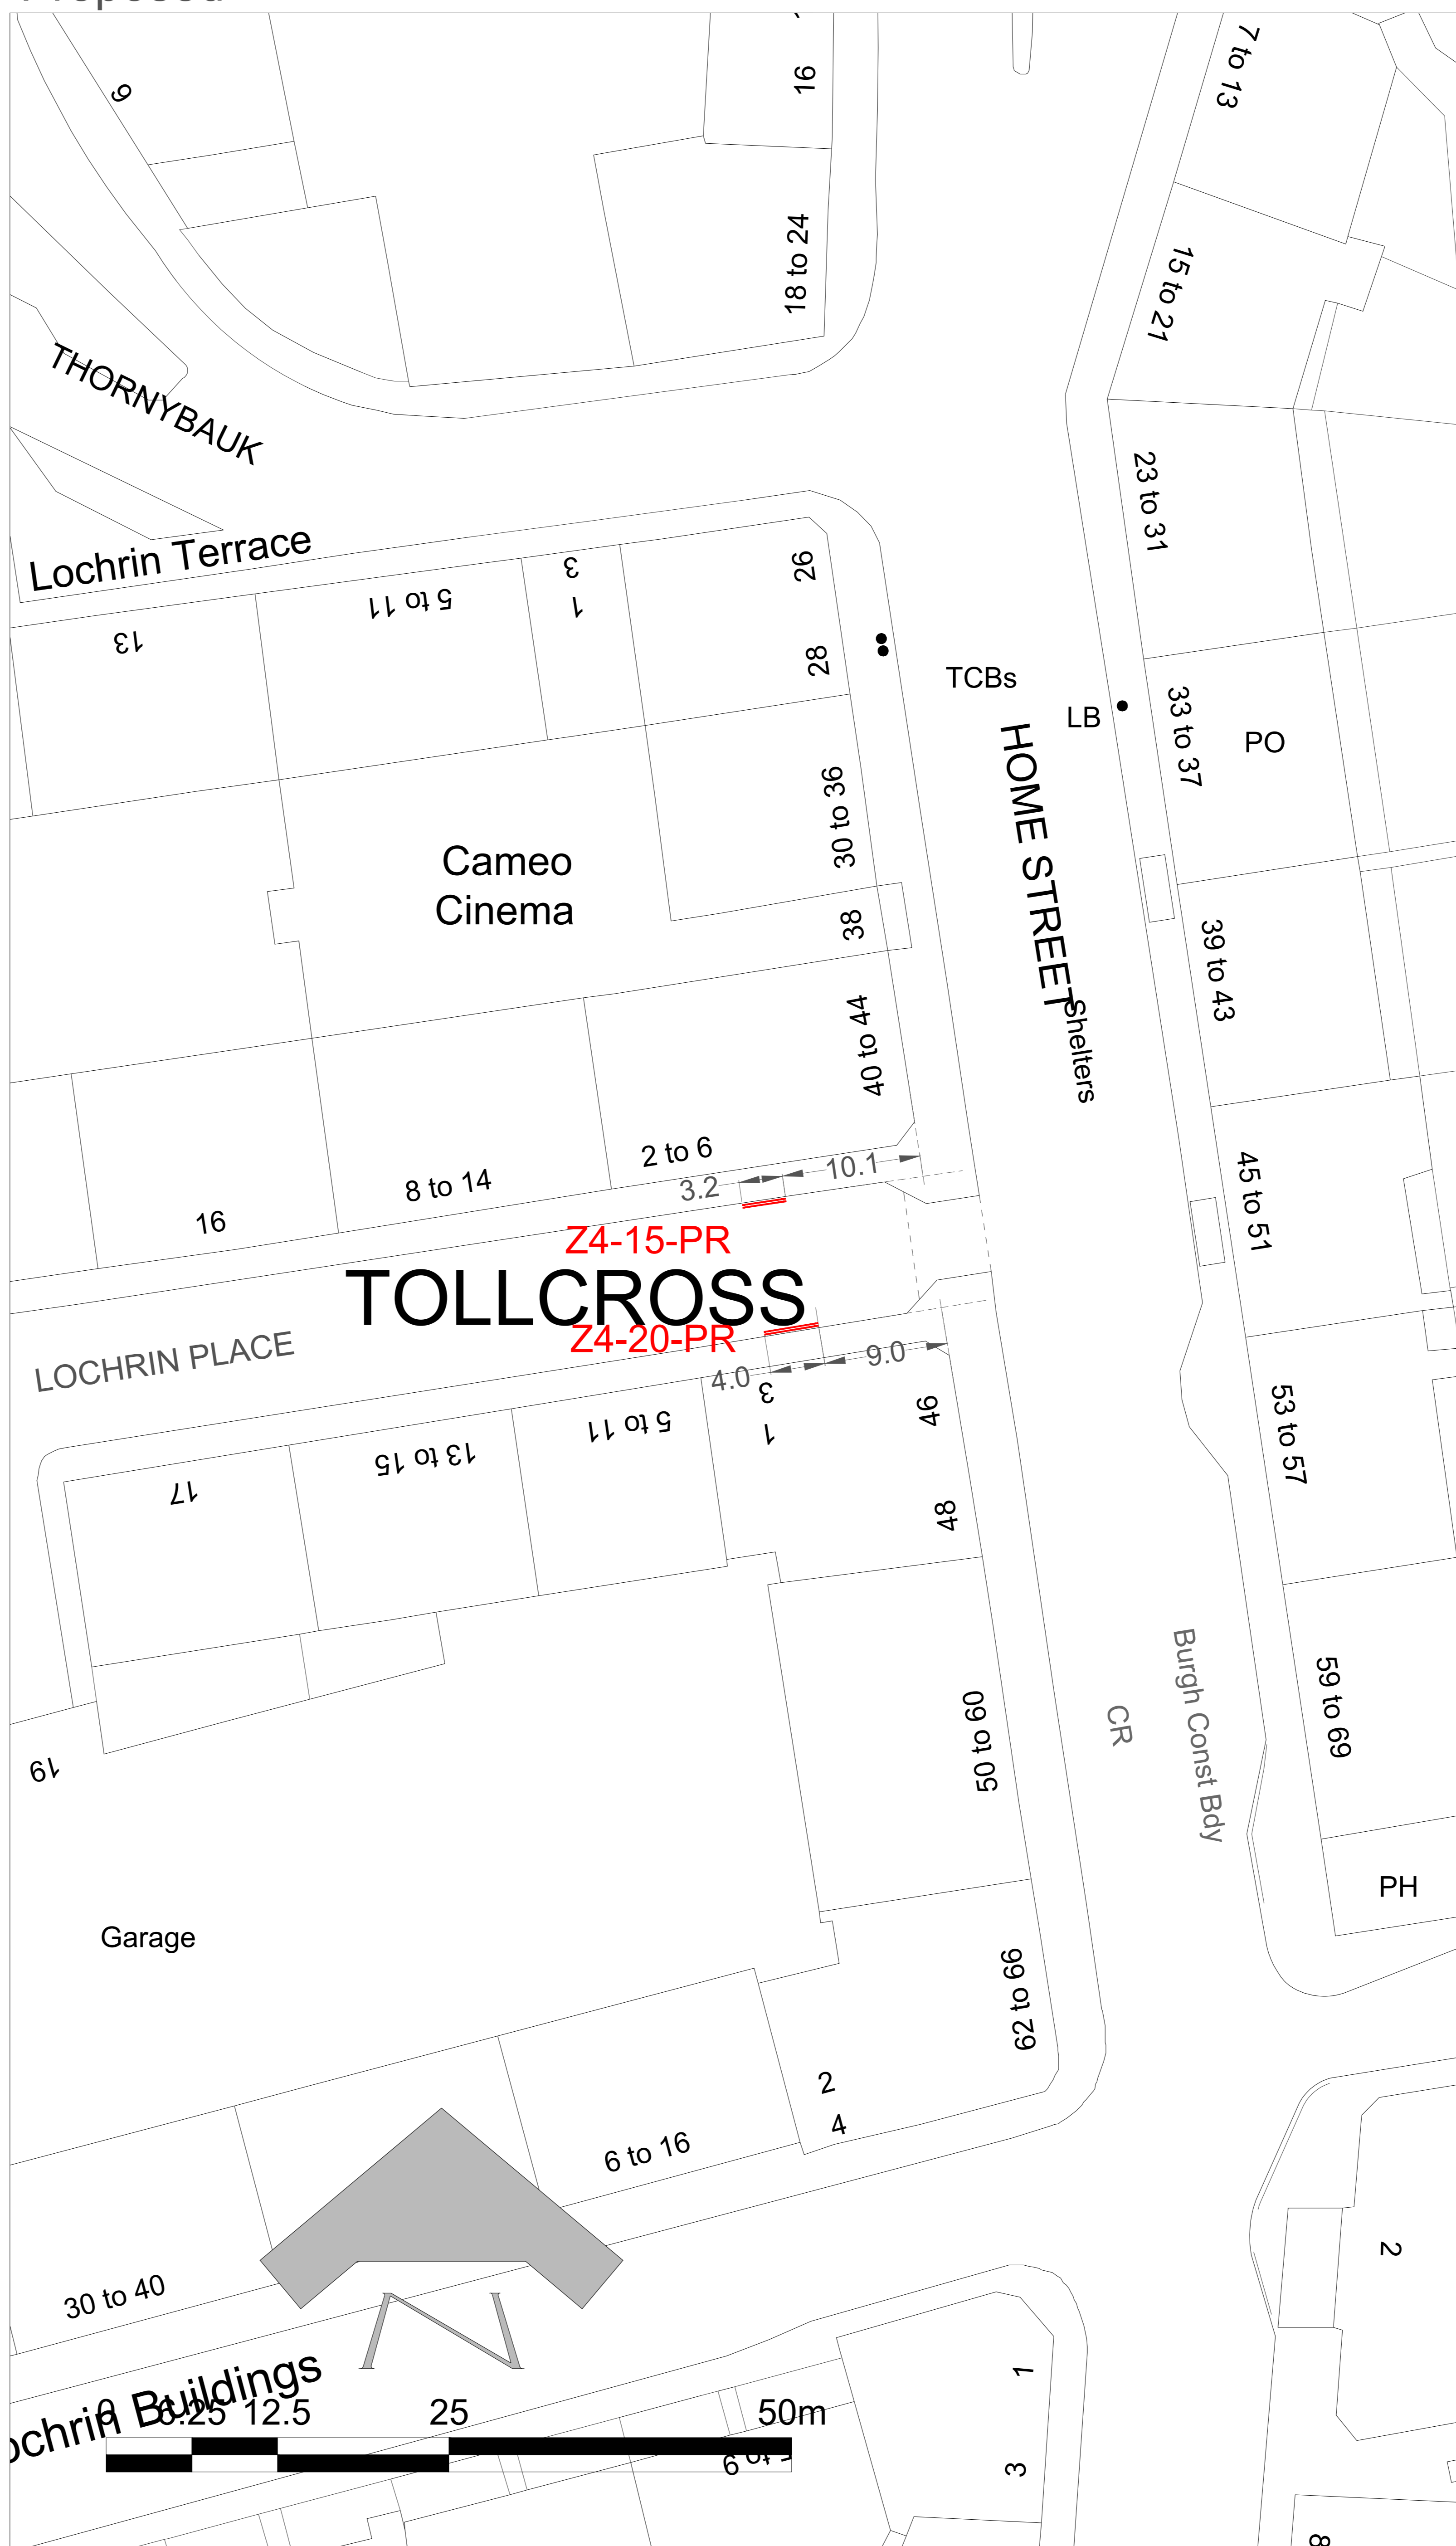

Current



Proposed



KEY

-  DOUBLE YELLOW LINE (DYL)
-  SINGLE RED LINE (SRL)
-  DOUBLE RED LINE (DRL)
-  LOADING BAY
-  GREENWAY LOADING BAY
-  GREENWAY PARKING BAY

This map is reproduced from Ordnance Survey material with the permission of Ordnance Survey on behalf of the Controller of Her Majesty's Stationery Office © Crown copyright. Unauthorised reproduction infringes Crown copyright and may lead to prosecution or civil proceedings.

100023420 (2015)

A	CHANGES FOLLOWING T.O. TEAM COMMENTS	MP	27/08/24	JT
REVISION	DETAILS	BY	DATE	CHECKED

EDINBURGH
THE CITY OF EDINBURGH COUNCIL


The City of Edinburgh Council
Waverley Court, 4 East Market Street
Edinburgh, EH8 8BG
Telephone: 0131 200 2000

WASTE


COMMUNAL BIN REVIEW
AMENDMENTS TO TEXT-BASED ORDERS
PAGE 8

Date: 30/05/2024	Job No.	Drawn by: MP
Scale: 1:250 @A0		Checked by: JT



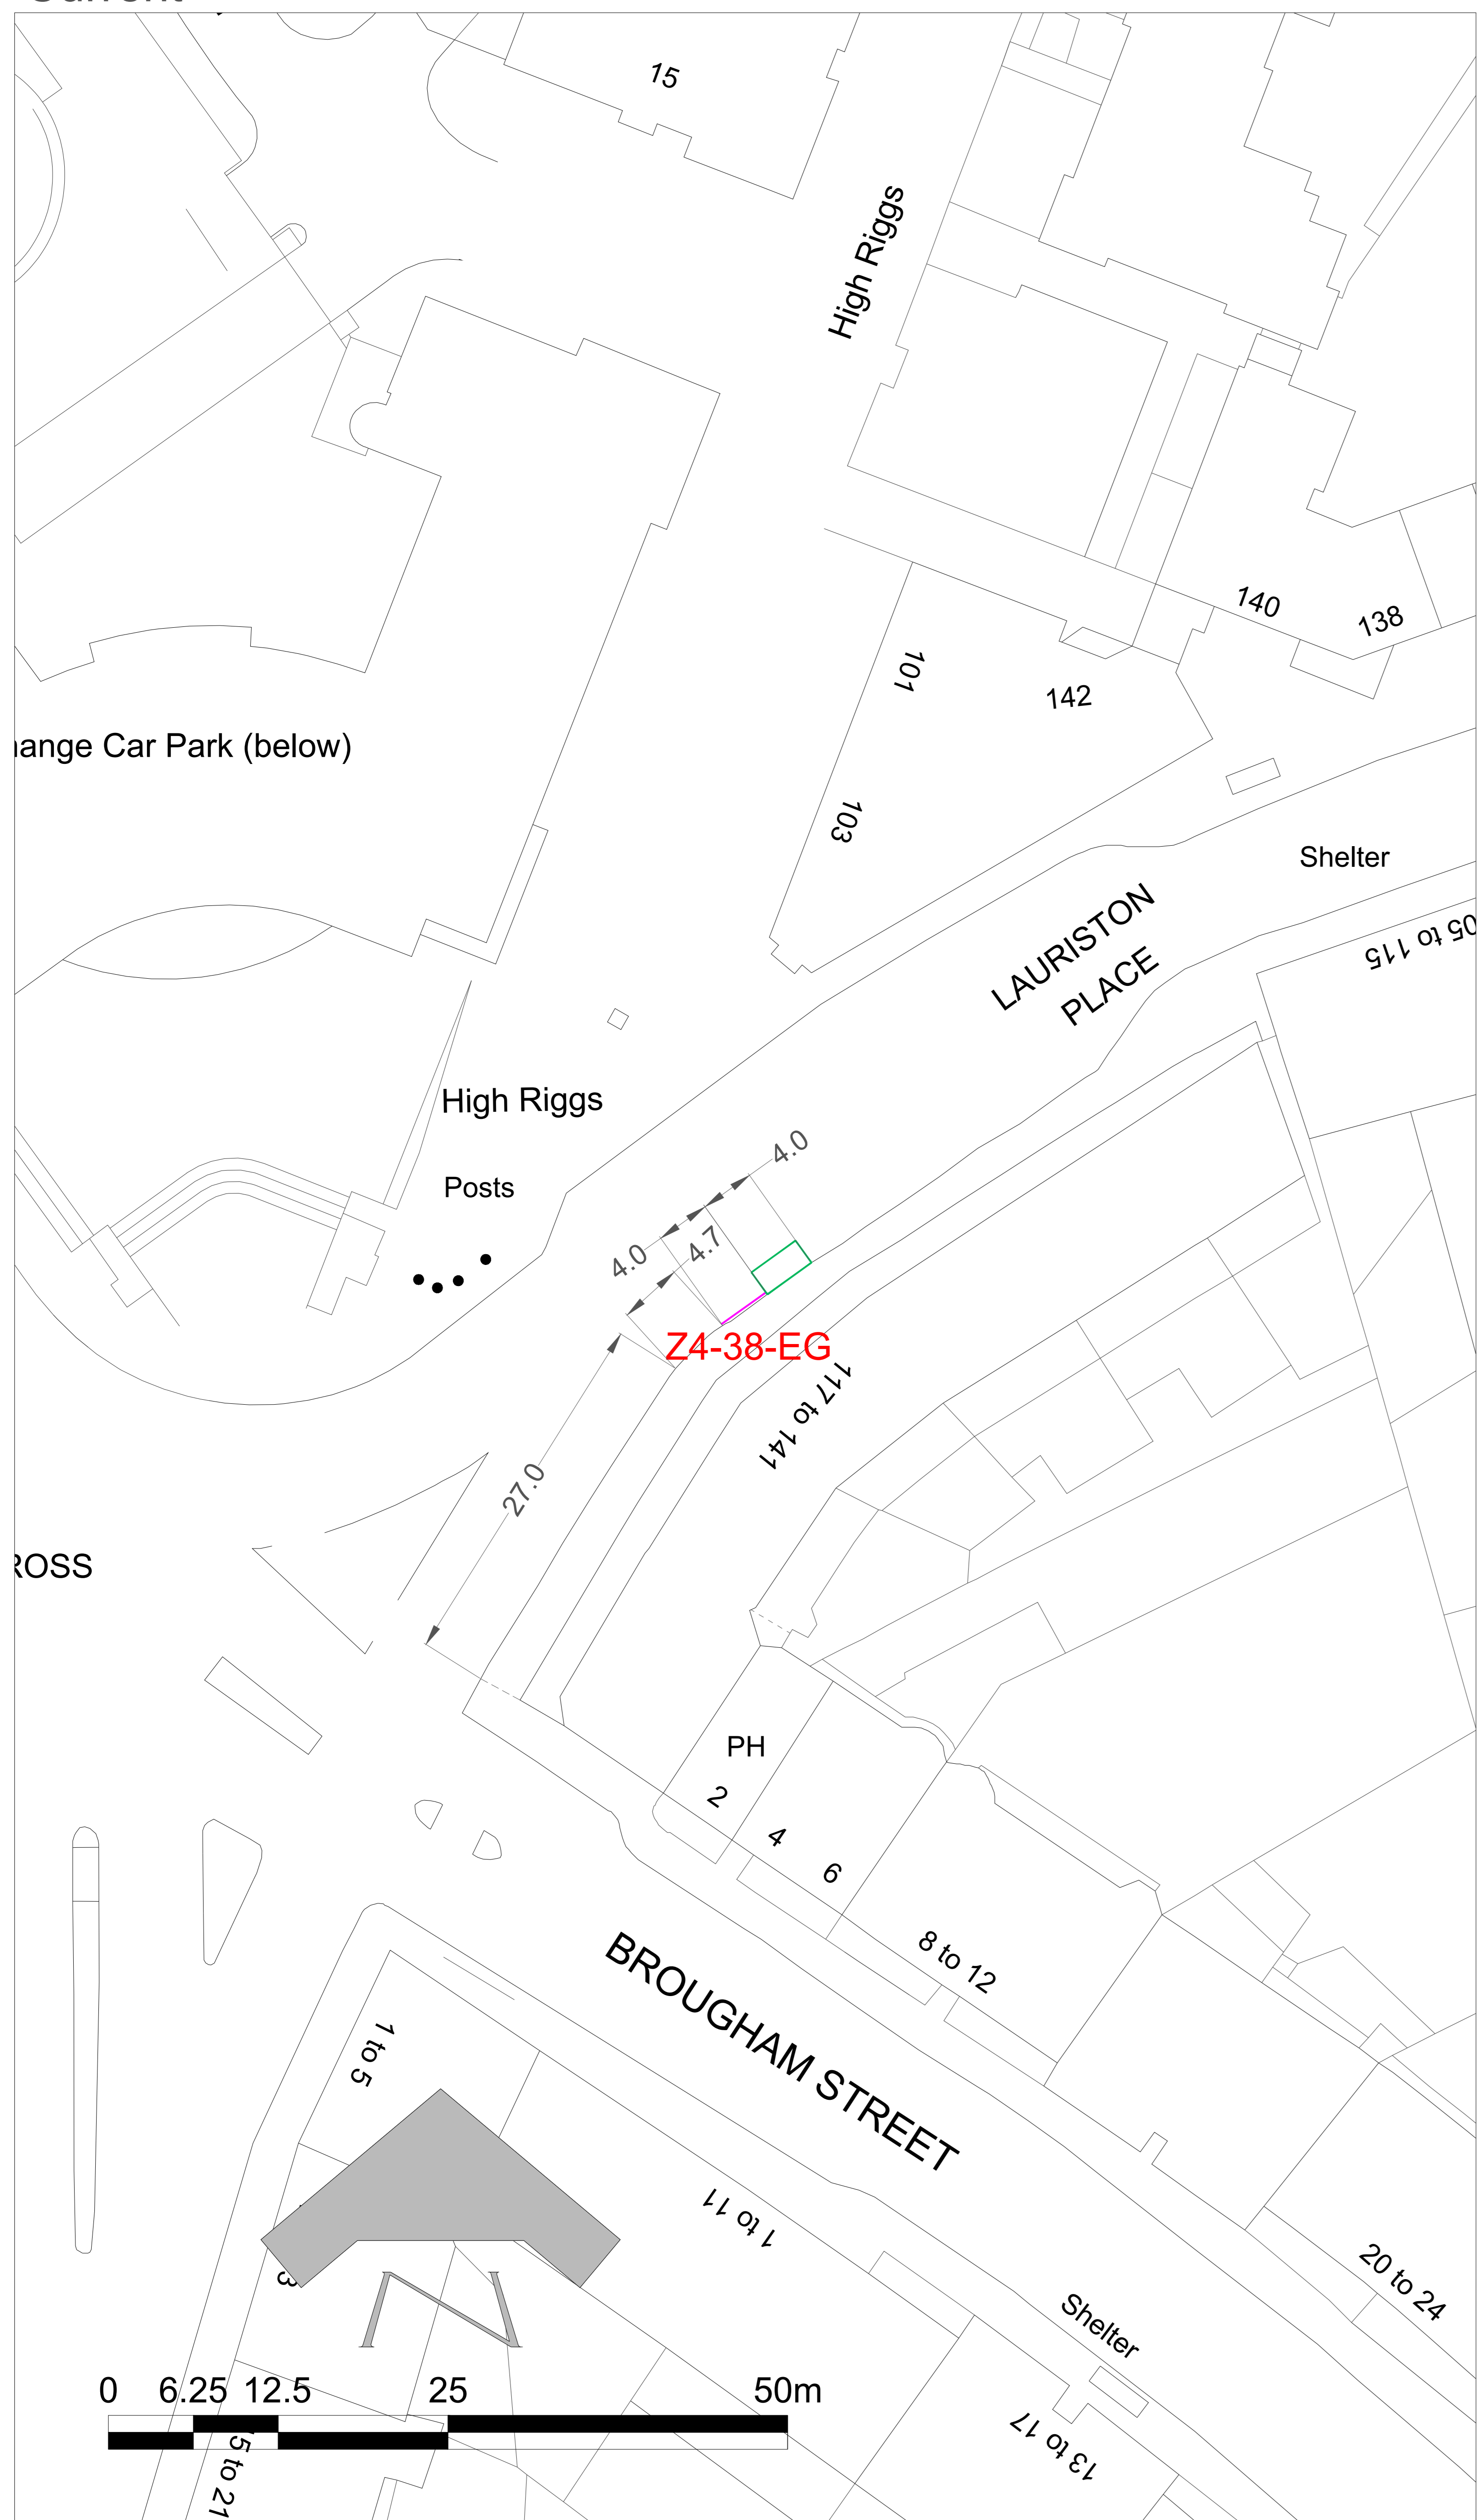

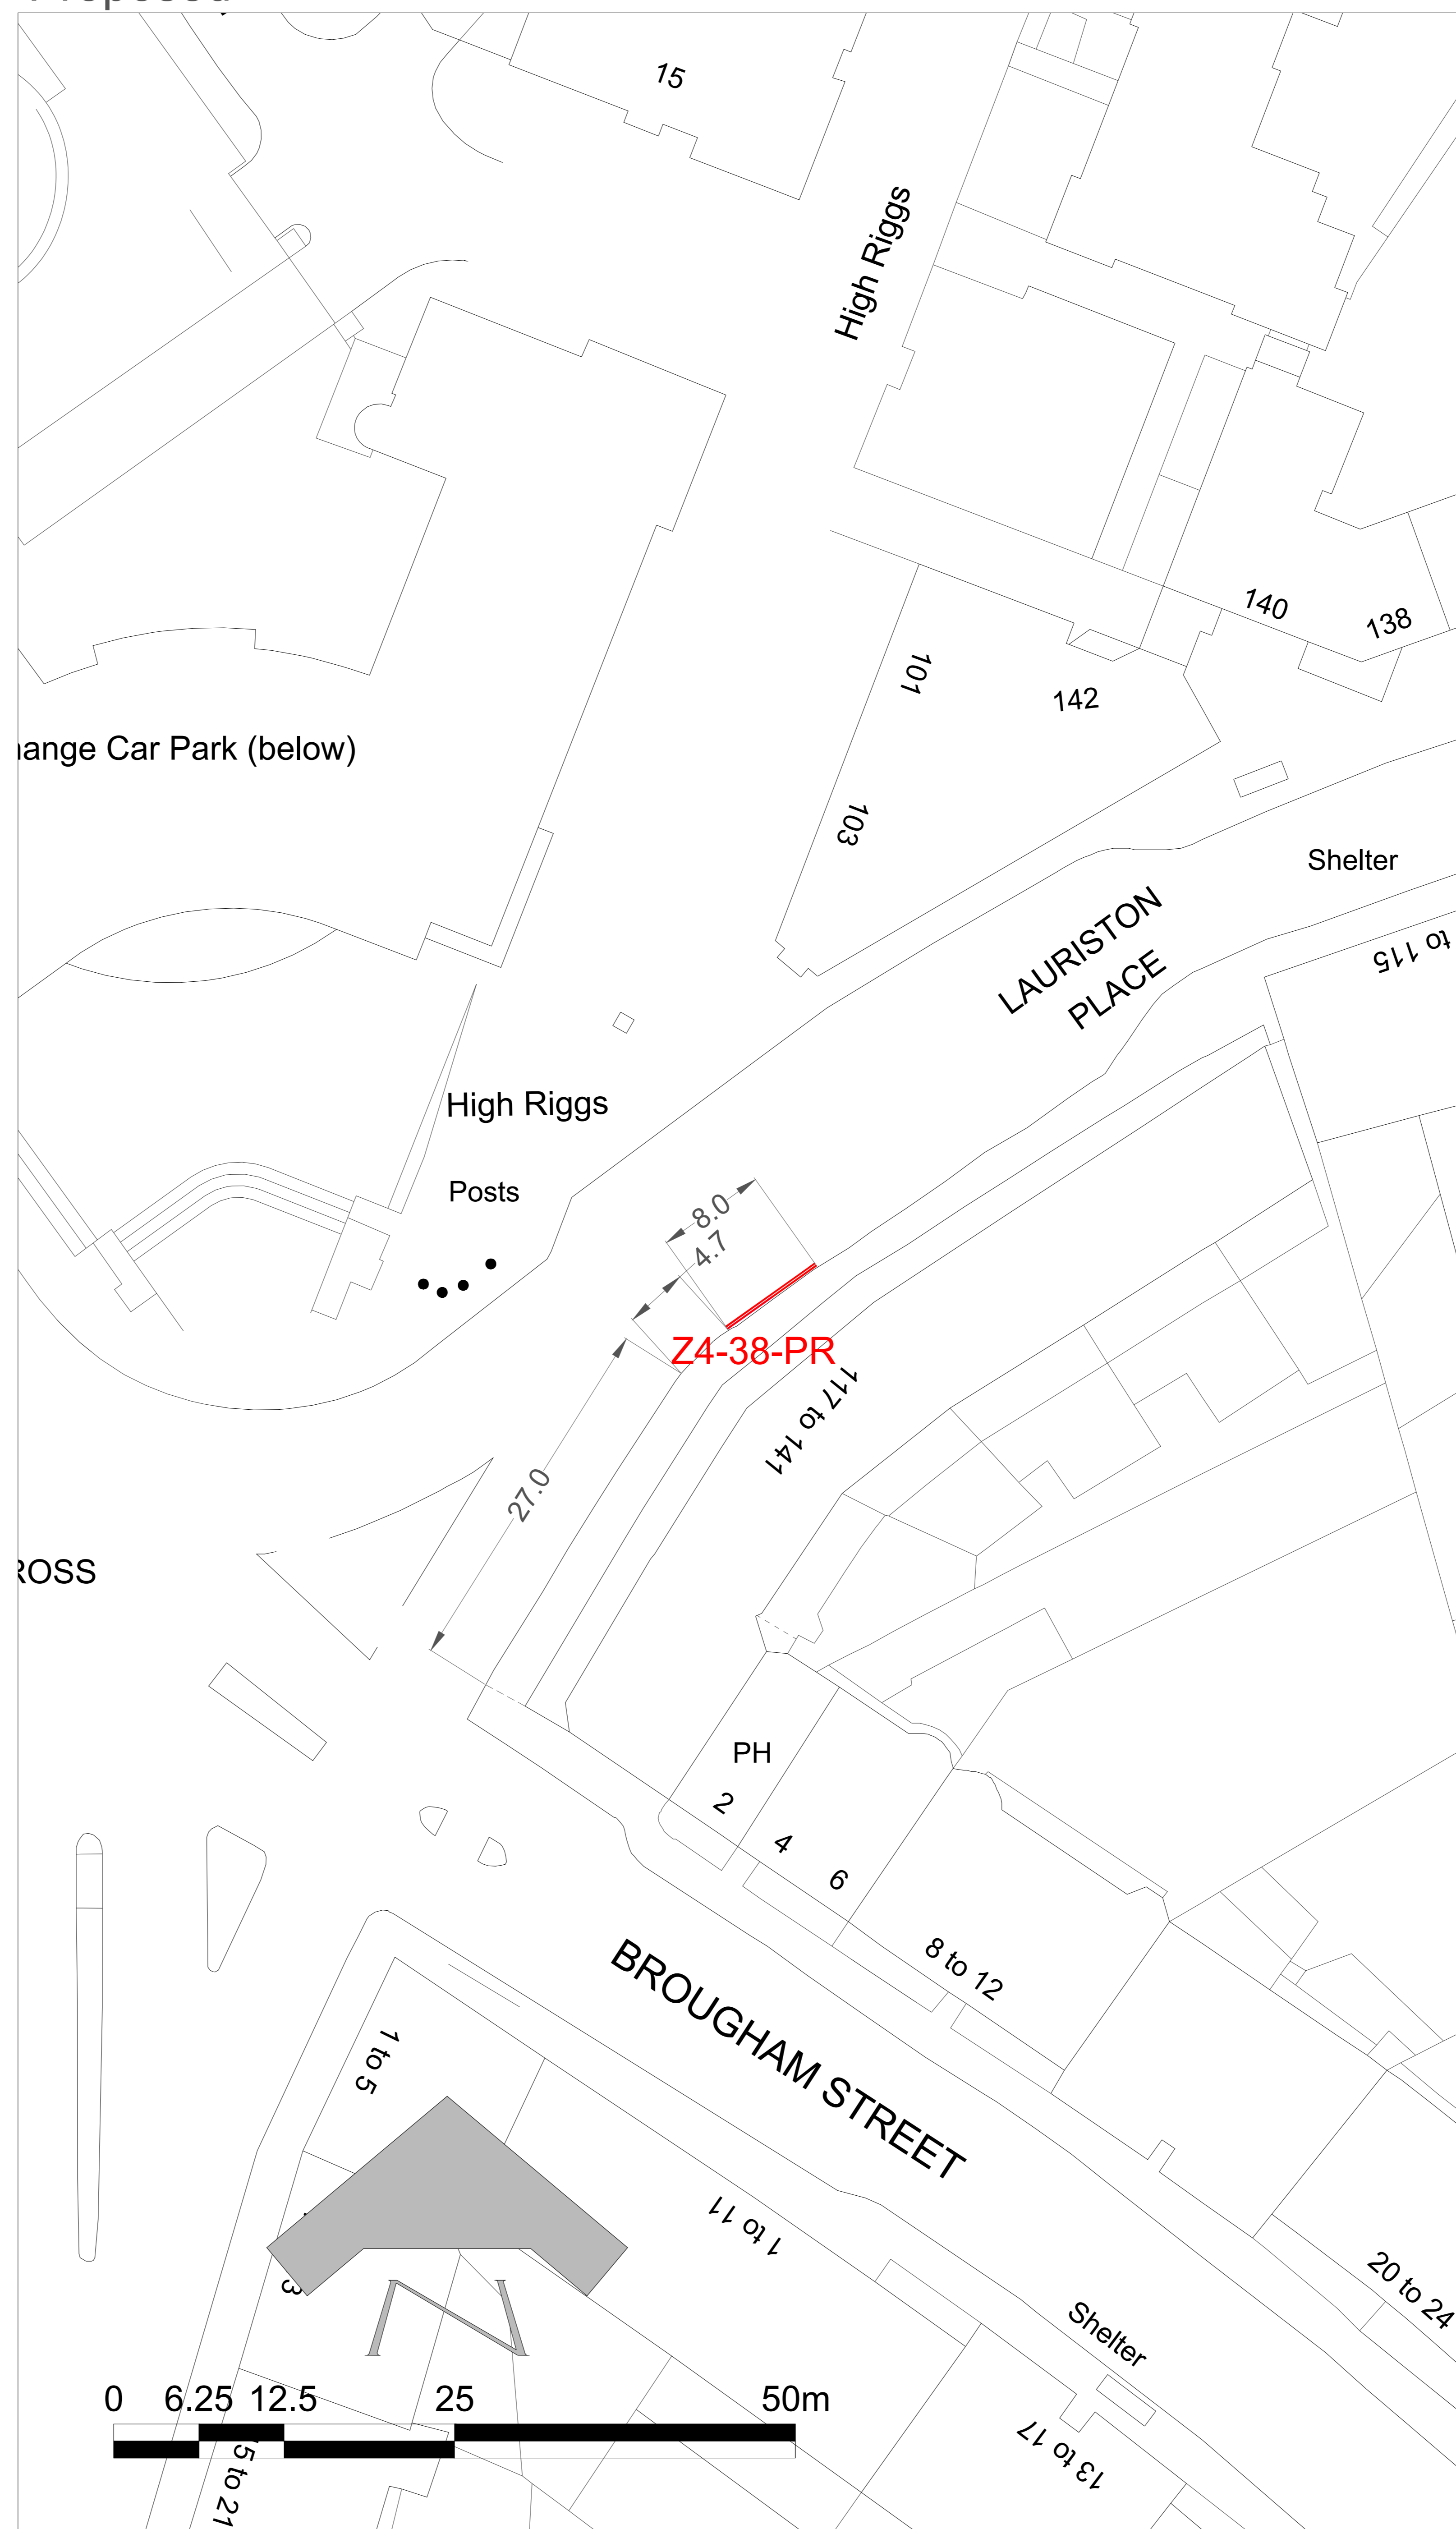

Current



Proposed



KEY

-  DOUBLE YELLOW LINE (DYL)
-  SINGLE RED LINE (SRL)
-  DOUBLE RED LINE (DRL)
-  LOADING BAY
-  GREENWAY LOADING BAY
-  GREENWAY PARKING BAY

This map is reproduced from Ordnance Survey material with the permission of Ordnance Survey on behalf of the Controller of Her Majesty's Stationery Office © Crown copyright. Unauthorised reproduction infringes Crown copyright and may lead to prosecution or civil proceedings.

100023420 (2015)

A	CHANGES FOLLOWING T.O. TEAM COMMENTS	MP	27/08/24	JT
REVISION	DETAILS	BY	DATE	CHECKED

EDINBURGH
THE CITY OF EDINBURGH COUNCIL

The City of Edinburgh Council
Waverley Court, 4 East Market Street
Edinburgh, EH8 8BG
Telephone: 0131 200 2000

WASTE

COMMUNAL BIN REVIEW
AMENDMENTS TO TEXT-BASED ORDERS

PAGE 9

Date: 30/05/2024 Job No. Drawn by: MP
Scale: 1:250 @A0 Checked by: JT